

MONROE
Q64
2-22-73

MISSISSIPPI
BOARD OF WATER COMMISSIONERS
416 North State Street
Jackson, Mississippi 39201

CODED

WATER WELL DRILLERS LOG

2-22 1973 W. J. REEVES & SON MONROE
date well completed firm name county well located

LANDOWNER: HAMILTON MIDLINE
Co.
HAMILTON

description of formations encountered	from	to
CLAY	0	15
SAND & GRAVEL	15	31
BLUE SD + CLAY STRS	31	80
BLUE CLAY	80	84
" SAND	84	100

(mailing address)

WELL LOCATION:
sec. 21 T-15 N R-18 E
1 miles E of HAMILTON
(distance) (direction) (nearest town)

WELL PURPOSE: HOES
(home, irrigation, municipal, industrial)

WELL COMPLETION DATA:

- (1) diameter (inches) 4
- (2) total depth (feet) 100
- (3) static water level (feet) 25 below top of ground.
- (4) casing PVC 80 (material), (depth)
4 (size) if telescope see back.
- (5) screen 20 80 (length), (depth to top)
4 PVC (size), (material)
- (6) pump 1 18 (HP), (yield gpm)
ELECT (type power)
- (7) electric log No (yes or no)
- (8) how well bottom plugged wood

CODED


DRILLERS REMARKS:

MISS. 0 2072
APR 1973

MISS. 00 17

If well telescopes please sketch and show depths.

GROUND LEVEL

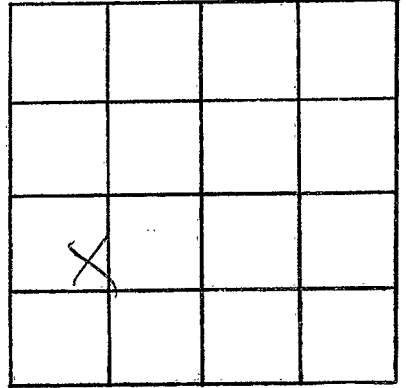

SECTION 21

Please indicate well location X.

ADDITIONAL INFORMATION

If more than one screen, show locations of each on sketch.