

MONROE

Q 65

2-24-73

MISSISSIPPI BOARD OF WATER COMMISSIONERS
416 North State Street
Jackson, Mississippi 39201

CODED

WATER WELL DRILLERS LOG

2-24 1973
date well completed

W. J. REEVES & SON
firm name

MONROE
county well located

LANDOWNER: R. B. CARRETT

RT. 1

HAMILTON

(mailing address)

WELL LOCATION:

sec 23 T 15 N R 18 E
S W
4 miles E of HAMILTON
(distance) (direction) (nearest town)

WELL PURPOSE: HOME
(home, irrigation, municipal, industrial)

WELL COMPLETION DATA:

- (1) diameter (inches) 4
- (2) total depth (feet) 80
- (3) static water level (feet) 26 below above top of ground.
- (4) casing PVC 60 (material) (depth)
4 (size) if telescope see back.
- (5) screen 20 60 (length) (depth to top)
4 PVC (size) (material)
- (6) pump 1/2 10 (HP) (yield gpm)
ELECT (type power)
- (7) electric log NO (yes or no)

(organization running log)

(8) how well bottom plugged WOOD

description of formations encountered

from

to

CLAY

0

17

RD. SAND

17

78

BLUE CLAY

78

80

CODED


DRILLERS REMARKS:

W. J. REEVES & SON 1072

MISS. S.

If well telescopes please sketch and show depths.

GROUND LEVEL

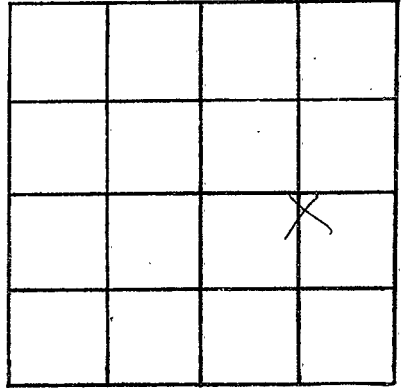

SECTION 23

Please indicate well location X.

ADDITIONAL INFORMATION

If more than one screen, show locations of each on sketch.