

MONROE
Q 72
2-18-74

MISSISSIPPI
 BOARD OF WATER COMMISSIONERS
 416 North State Street
 Jackson, Mississippi 39201

CODED

WATER WELL DRILLERS LOG

2-18 1974 W. J. REEVES 2 SON MONROE
 date well completed firm name county well located

LANDOWNER: BILLY PACE
HAMILTON
 (mailing address)

description of formations encountered	from	to
<u>CLAY</u>	<u>0</u>	<u>22</u>
<u>RED SAND</u>	<u>22</u>	<u>100</u>
<u>BLUE CLAY</u>	<u>100</u>	<u>102</u>

WELL LOCATION:
 sec. 11 T. 15 N. R. 18 E.
5 miles NE of HAMILTON
 (distance) (direction) (nearest town)

WELL PURPOSE: HOME
 (home, irrigation, municipal, industrial)

CODED


- WELL COMPLETION DATA:
- (1) diameter (inches) 4
 - (2) total depth (feet) 102
 - (3) static water level (feet) 46 below top of ground.
 - (4) casing PVC, 82 (material) (depth)
4 (size) if telescope see back.
 - (5) screen 20, 82 (length) (depth to top)
4 (size) PVC (material)
 - (6) pump 1/2, 10 (HP) (yield gpm)
ELECT (type power)
 - (7) electric log NO (yes or no)
 (organization running log)
 - (8) how well bottom plugged SAND

DRILLERS REMARKS:

REC
NOV 1 1974
MISSISSIPPI
WATER BOARD

If well telescopes please sketch and show depths.

GROUND LEVEL

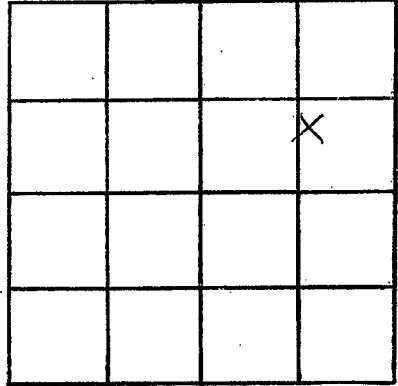

SECTION 11

Please indicate well location X.

ADDITIONAL INFORMATION

If more than one screen,
show locations of each on sketch.