

MISSISSIPPI DEPARTMENT OF NATURAL RESOURCES

Bureau of Land and Water Resources

Southport Mall

P.O. Box 10631

Jackson, Mississippi 39209

WATER WELL DRILLERS LOG

CODED

Monroe
Q 77
6-17-81

6-17 1981 Clardy Well Drilling Monroe
 date well completed firm name county well located

LANDOWNER:
Texas Oil & Gas Co.
New Hamilton, MS,
 (mailing address)

description of formations encountered	from	to
<u>Sand & gravel</u>	<u>10</u>	<u>42</u>
<u>Sandy silty clay</u>	<u>42</u>	<u>75</u>
<u>Sandy streaks</u>	<u>75</u>	<u>90</u>
<u>Clay</u>	<u>90</u>	<u>230</u>
<u>Silted</u>	<u>230</u>	<u>255</u>
<u>Gummy clay</u>	<u>255</u>	<u>260</u>

WELL LOCATION:
 sec. 7 T. 16 N. R. 19 E.
3 miles SW of New Hamilton
 (distance) (direction) (nearest town)

WELL PURPOSE: Water for Drilling
 (home, irrigation, municipal, industrial)

WELL COMPLETION DATA:

(1) diameter (inches) 4"

(2) total depth (feet) 260'

(3) static water level (feet) 60' below above top of ground.

(4) casing PVC 94'
 (material) (depth)

_____ if telescope see back.
 (size)

(5) screen _____
 (length) (depth to top)

_____ (size) _____ (material)

(6) pump _____ (HP) _____ (yield gpm)

_____ (type power)

(7) electric log _____ (yes or no)

_____ (organization running log)

(8) how well bottom plugged _____

DRILLERS REMARKS:

CODED


DEPT. OF NATURAL RESOURCES
 BUREAU OF LAND & WATER RESOURCES

JUL - 2 1981

RECEIVED

If well telescopes please sketch and show depths.

GROUND LEVEL

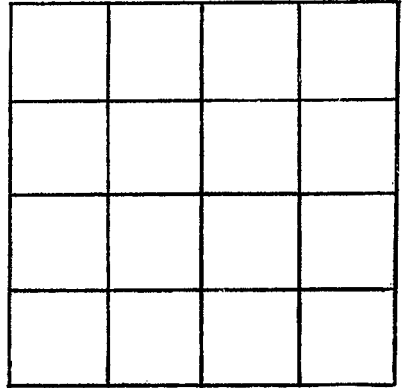

SECTION _____

Please indicate well location X.

ADDITIONAL INFORMATION

If more than one screen,
show locations of each on sketch.