

MISSISSIPPI DEPARTMENT OF NATURAL RESOURCES

Bureau of Land and Water Resources

Southport Mall

P.O. Box 10631

Jackson, Mississippi 39209

WATER WELL DRILLERS LOG

Griner Drilling Service, Inc.

Monroe

MONROE
Q 79
1/8/26

date well completed

firm name

county well located

LANDOWNER:

Pruet Production
217 West Capitol St.
Jackson, MS. 39201
(mailing address)

description of formations encountered

from

to

clay, sand

0 315

sand

315 357

WELL LOCATION: *1972'S & 2310'E*

sec. *36* T. *15* N. R. *18* E. *newton*

No 1
Coleman *2 1/2 mi S* *Maple Branch*
(distance) (direction) (nearest town)

R low

WELL PURPOSE: *oilfield study*
(home, irrigation, municipal, industrial)

WELL COMPLETION DATA:

- (1) diameter (inches) *3"*
- (2) total depth (feet) *357'*
- (3) static water level (feet) *100'* ^(below) _{above} top of ground.

CODED

- (4) casing *steel*, *357'*
(material) (depth)
3"
(size) if telescope see back.

- (5) screen *42'*, *315'*
(length) (depth to top)
3", *perforated*
(size) (material)

- (6) pump *Ø*, *70*
(HP) (yield gpm)
AC
(type power)

- (7) electric log (yes or no)

(organization running log)

- (8) how well bottom plugged *orange*
peel

DRILLERS REMARKS:


DEPT. OF NATURAL RESOURCES
BUREAU OF LAND & WATER RESOURCES

JAN 24 1983

RECEIVED

If well telescopes please sketch and show depths.

GROUND LEVEL

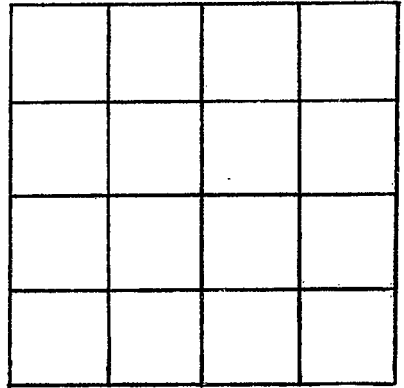

SECTION _____

Please indicate well location X.

ADDITIONAL INFORMATION

If more than one screen,
show locations of each on sketch.