

MISSISSIPPI
 BOARD OF WATER COMMISSIONERS
 416 North State Street
 Jackson, Mississippi 39201

WATER WELL DRILLERS LOG

CODED

MON ROE
Q 93

11-9-84 19 Mid South Drilling Company Monroe
 date well completed firm name county well located

LANDOWNER: Hamilton Primitive Baptist Church c/o William Smith 418 Wonterset Drive Columbus, MS 39702 (mailing address)	description of formations encountered	from	to
	clay	0	5
	sand and gravel	5	28

WELL LOCATION:
 sec 9 T 16S R 18W E
 S W
 3 miles south of Hamilton
 (distance) (direction) (nearest town)

CODED

WELL PURPOSE: church
 (home, irrigation, municipal, industrial)

- WELL COMPLETION DATA:**
- (1) diameter (inches) 4"
 - (2) total depth (feet) 28
 - (3) static water level (feet) 6 below ~~depth~~ top of ground.
 - (4) casing pvc 18' (material) (depth)
 4" (size) if telescope see back.
 - (5) screen 10' 18' (length) (depth to top)
 4" pvc (size) (material)
 - (6) pump none (HP) (yield gpm)
 (type-power)
 - (7) electric log no (yes or no)
 no (organization running log)
 - (8) how well bottom plugged ~~no~~ screen

DEPT. OF NATURAL RESOURCES
 BUREAU OF LAND & WATER RESOURCES


NOV 26 1984

RECEIVED

DRILLERS REMARKS:

If well telescopes please sketch and show depths.

GROUND LEVEL

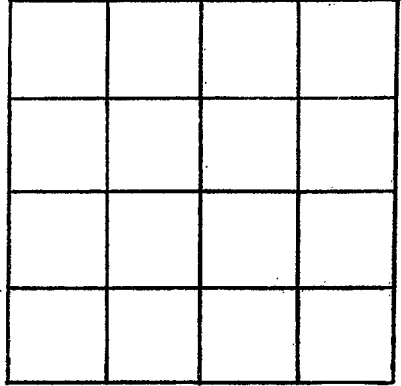

SECTION _____

Please indicate well location X.

ADDITIONAL INFORMATION

If more than one screen,
show locations of each on sketch.