

MISSISSIPPI DEPARTMENT OF NATURAL RESOURCES
Bureau of Land and Water Resources
 Southport Mall
 P.O. Box 10631
 Jackson, Mississippi 39209
WATER WELL DRILLERS LOG

CODED

<u>MONROE</u>
<u>Q 9A</u>
<u>7-7-81</u>

July 7 1981 Allsup Drilling, Inc. Monroe
 date well completed firm name county well located


LANDOWNER: <u>Bean Dredging, Inc.</u>	description of formations encountered	from	to
<u>P O Box 396</u> <u>Hamilton, MS 39746</u> (mailing address)			
	<u>Sand & Gravel</u>	<u>10</u>	<u>20'</u>
	<u>Muck</u>	<u>20</u>	<u>50'</u>
	<u>Water Sand</u>	<u>50</u>	
WELL LOCATION:			
sec. <u>24</u> T <u>15</u> N R <u>18</u> E S			
<u>2 1/2</u> miles <u>West</u> of <u>Hamilton</u> (distance) (direction) (nearest town)			
WELL PURPOSE: <u>Industrial</u> (home, irrigation, municipal, industrial)			
WELL COMPLETION DATA:			
(1) diameter (inches) <u>4"</u>			
(2) total depth (feet) <u>220'</u>			
(3) static water level (feet) _____ below above top of ground.			
(4) casing <u>PVC</u> , <u>220'</u> (material) (depth)			
<u>4" x 2"</u> if telescope see back. (size)			
(5) screen <u>40'</u> , <u>180'</u> (length) (depth to top)			
<u>2"</u> , <u>PVC</u> (size) (material)			
(6) pump <u>5</u> , <u>70</u> (HP) (yield gpm)			
<u>Electric</u> (type power)			
(7) electric log <u>No</u> (yes or no)			
_____ (organization running log)			
(8) how well bottom plugged <u>capped</u>			
DRILLERS REMARKS:			

DEPT. OF NATURAL RESOURCES
 BUREAU OF LAND & WATER RESOURCES
 DEC 12 1984
RECEIVED

If well telescopes please sketch and show depths.

GROUND LEVEL

180' 4" Casing

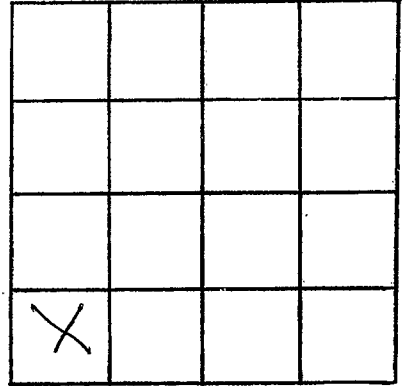

SECTION _____

Please indicate well location X.

ADDITIONAL INFORMATION

40' 2" Screen

| |
| |
If more than one screen, show locations of each on sketch.