

MISSISSIPPI DEPARTMENT OF NATURAL RESOURCES
Bureau of Land and Water Resources
 Southport Mall
 P.O. Box 10631
 Jackson, Mississippi 39209
WATER WELL DRILLERS LOG

MONROE
GW 14803
98

Sept. 2 19 94 LAYNE-CENTRAL Monroe
 date well completed firm name county well located

LANDOWNER:	description of formations encountered	from	to
Kerr McGee Chemical Company 39746 P.O. Box 180, Hamilton, MS (mailing address)			
WELL LOCATION: sec. <u>19</u> T. <u>16</u> N. R. <u>18</u> E. 1 miles W. Hwy 45 Hamilton (distance) (direction) (nearest town)			
WELL PURPOSE: Industrial (home, irrigation, municipal, industrial)			
WELL COMPLETION DATA:			
(1) diameter (inches) <u>16"</u>			
(2) total depth (feet) <u>406</u>			
(3) static water level (feet) <u>55</u> below top of ground.			
(4) casing <u>Steel</u> <u>338</u> (material) (depth)			
<u>16"</u> if telescope see back. (size)			
(5) screen <u>60</u> <u>343</u> (length) (depth to top)			
<u>10"</u> <u>S.S.</u> (size) (material)			
(6) pump <u>125</u> <u>1000</u> (HP) (yield gpm)			
<u>3/60/460</u> (type power)			
(7) electric log <u>Yes</u> (yes or no)			
<u>LAYNE-CENTRAL</u> (organization running log)			
(8) how well bottom plugged <u>SS</u> <u>Plate</u>			

*313
103*

RECEIVED


SEP 23 1994

Dept. of Environmental Quality
 Office of Land & Water Resources

DRILLERS REMARKS:
 Well #14

If well telescopes please sketch and show depths.

GROUND LEVEL

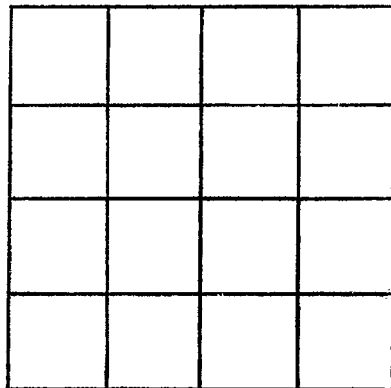

SECTION _____

Please indicate well location X.

ADDITIONAL INFORMATION

If more than one screen, show locations of each on sketch.