

Monroe
 Q 200
 1-67

MISSISSIPPI
 BOARD OF WATER COMMISSIONERS
 416 North State Street
 Jackson, Mississippi 39201

WATER WELL DRILLERS LOG

1-2 date well completed 1967 W. J. REEVES & SON firm name MONROE county well located

LANDOWNER: ROY TUCKER


description of formations encountered	from	to
RED CLAY	0	22
RED SAND & CLAY	22	85
RED SAND	85	109
BLUE CLAY	109	111

HAMILTON, MISS.
 (mailing address)

WELL LOCATION:
 sec. 13 T. 15 S. R. 18 W.
 6 miles E of HAMILTON
 (distance) (direction) (nearest town)

WELL PURPOSE: POULTRY
 (home, irrigation, municipal, industrial)


- WELL COMPLETION DATA:
- (1) diameter (inches) 4
 - (2) total depth (feet) 111
 - (3) static water level (feet) 60 below above top of ground.
 - (4) casing PVC 111'
 (material) (depth)
 (size) if telescope see back.
 - (5) screen 20' 89'
 (length) (depth to top)
4 PVC
 (size) (material)
 - (6) pump 1/2 10
 (HP) (yield gpm)
ELECT.
 (type power)
 - (7) electric log NO
 (yes or no)
 (organization running log)
 - (8) how well bottom plugged SAND

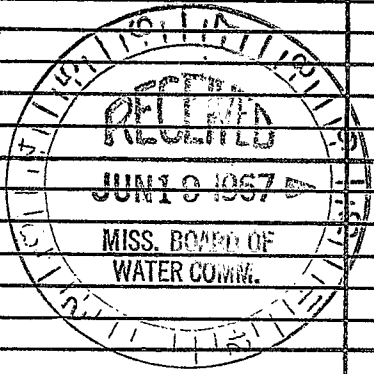

DRILLERS REMARKS:
 8" DRILL HOLE
 GRAVEL PACKED

If well telescopes please sketch and show depths.

GROUND LEVEL

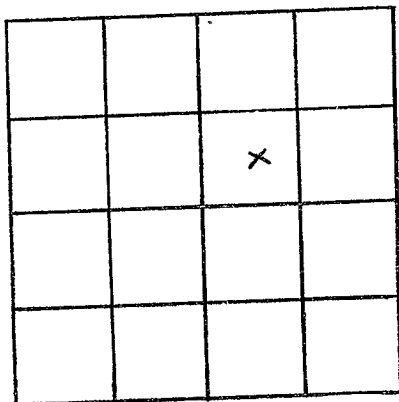

SECTION 13

Please indicate well location X.

ADDITIONAL INFORMATION

If more than one screen,
show locations of each on sketch.