

Monroe
 Q 2022
 8-1-75

MISSISSIPPI
 BOARD OF WATER COMMISSIONERS
 416 North State Street
 Jackson, Mississippi 39201


WATER WELL DRILLERS LOG

8-1 date well completed 1975 W. J. REEVES & SON firm name MONROE county well located

LANDOWNER: CALVIN SELF	description of formations encountered	from	to
HAMILTON (mailing address)	CLAY	0	18
WELL LOCATION: sec. 18 T. 16 N. R. 18 S. 13D	SAND & GRAVEL	18	22
4 miles SO of HAMILTON (distance) (direction) (nearest town)	BLUE CLAY & SILT	22	35
WELL PURPOSE: HOME (home, irrigation, municipal, industrial)	BLUE CLAY	35	44
WELL COMPLETION DATA:	RED SAND	44	60
(1) diameter (inches) 4			
(2) total depth (feet) 60			
(3) static water level (feet) 30 below top of ground.			
(4) casing PVC, 50 (material) (depth) 4 (size) If telescope see back.			
(5) screen 10, 50 (length) (depth to top) 4, PVC (size) (material)			
(6) pump 1/2, 8 (HP) (yield gpm) ELECT (type power)			
(7) electric log NO (yes or no) (organization running log)			
(8) how well bottom plugged SAND			
DRILLERS REMARKS:	RECORDED		
	NOV 28 1975		
	MISS. BD. OF WATER COM.		

If well telescopes please sketch and show depths.

GROUND LEVEL

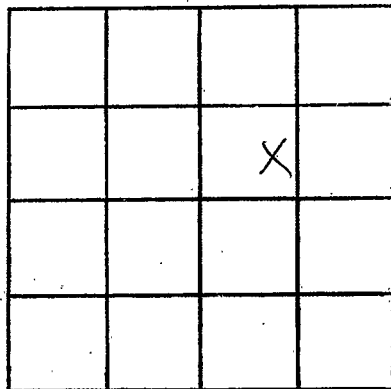

SECTION 18

Please indicate well location X.

ADDITIONAL INFORMATION

If more than one screen,
show locations of each on sketch.