

MONROE
Q. 2003
4-29-77

MISSISSIPPI
BOARD OF WATER COMMISSIONERS
416 North State Street
Jackson, Mississippi 39201

13L

WATER WELL DRILLERS LOG

4-29 1977
date well completed

Herman Homan Well & Supply, Inc.
P.O. Box 42
SHANNON, MISSISSIPPI 38868

Monroe
county well located

LANDOWNER:
Fred Bell
Attn: A. Davidson, Ms.
(mailing address)

description of formations encountered	from	to
Sand		
+ clay		
blue clay	0	35
sand	35	45
Bottom	45	140

WELL LOCATION:
SW/NE sec 30 T. 15 N R. 18 E
1 miles SW of New Hamilton
(distance) (direction) (nearest town)

WELL PURPOSE: Home
(home, irrigation, municipal, industrial)

- WELL COMPLETION DATA:
- (1) diameter (inches) 4"
 - (2) total depth (feet) 140'
 - (3) static water level (feet) 14' below top of ground.
 - (4) casing steel 4" (material) 91' (depth)
4" (size) if telescope see back.
 - (5) screen ND (length) (depth to top)
(size) (material)
 - (6) pump 1/2 (HP) 3 (yield gpm)
electric (type power)
 - (7) electric log ND (yes or no)
(organization running log)
 - (8) how well bottom plugged open


DRILLERS REMARKS:

RECEIVED
JUN 2 1977

MISS. Bd. OF WATER COMMISSIONERS

If well telescopes please sketch and show depths.

GROUND LEVEL

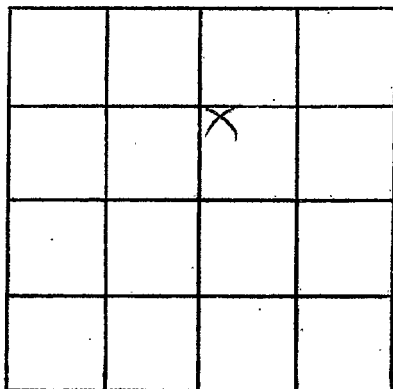

SECTION 30

Please indicate well location X.

ADDITIONAL INFORMATION

If more than one screen, show locations of each on sketch.