

MONROE

Q 2004

5-5-78

MISSISSIPPI
BOARD OF WATER COMMISSIONERS
416 North State Street
Jackson, Mississippi 39201

WATER WELL DRILLERS LOG

Lucky Community

5-5-1978
date well completed

Leese
firm name

Monroe
county well located

LANDOWNER:	description of formations encountered	from	to
Clyde Gibbs Pt. 2 Hamilton Ms. (mailing address)	Jointed clay Red sand Water bearing sand	0 10 121	10 120 158
WELL LOCATION:			
sec. 33 T. 15 N R. 2 E Lucky Community Hamilton 1.0 mi. S (distance) W (direction) (nearest town)			
WELL PURPOSE: (home, irrigation, municipal, industrial)			
WELL COMPLETION DATA:			
(1) diameter (inches) 4			
(2) total depth (feet) 158'			
(3) static water level (feet) _____ below/above top of ground.			
(4) casing Plastic 158' (material) (depth)			
_____ if telescope see back. (size)			
(5) screen 10 148 (length) (depth to top)			
4 PVC (size) (material)			
(6) pump 1/2 HP 10 (HP) (yield gpm)			
Elec. (type power)			
(7) electric log No (yes or no)			
_____ (organization running log)			
(8) how well bottom plugged wash valve			
DRILLERS REMARKS:			


RECEIVED

MAY 5 1978

MISS. BD. OF WATER COMMISSIONERS

If well telescopes please sketch and show depths.

GROUND LEVEL

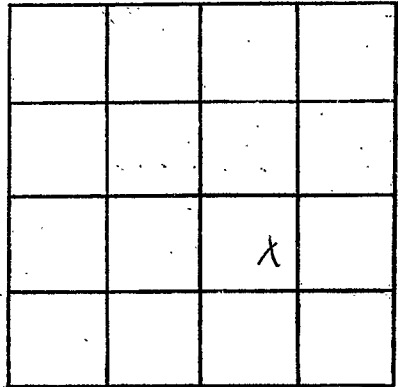

SECTION 33

Please indicate well location X.

ADDITIONAL INFORMATION

If more than one screen,
show locations of each on sketch.