

MONROE
Q 2805
5-17-78

**MISSISSIPPI  
BOARD OF WATER COMMISSIONERS**  
416 North State Street  
Jackson, Mississippi 39201

**WATER WELL DRILLERS LOG**

5-17-1978 Leaper Monroe  
 date well completed firm name county well located

**LANDOWNER:**  
Samuel L. Perkins  
Rt. 1 Hamilton Ms.  
 (mailing address)

description of formations encountered	from	to
<u>Top sand + clay</u>	<u>0</u>	<u>100</u>
<u>Blue clay</u>	<u>100</u>	<u>135</u>
<u>Sand</u>	<u>135</u>	<u>150</u>

**WELL LOCATION:**  
 sec. 3 T. 15 N. R. 18 E.  
5 1/2 miles NE of Lacey  
 (distance) (direction) (nearest town)

**WELL PURPOSE:** Home  
 (home, irrigation, municipal, industrial)

**WELL COMPLETION DATA:**

(1) diameter (inches) 4

(2) total depth (feet) 150

(3) static water level (feet) 140 below top of ground.

(4) casing PVC, 140,  
 (material) (depth)

4 If telescope see back.  
 (size)

(5) screen 10, PVC  
 (length) (depth to top)

4  
 (size) (material)

(6) pump 1/2, 4  
 (HP) (yield gpm)

Elec  
 (type power)

(7) electric log \_\_\_\_\_  
 (yes or no)

\_\_\_\_\_  
 (organization running log)


(8) how well bottom plugged Back  
wash valves

DRILLERS REMARKS:

**RECEIVED**  
 AUG 29 1978  
 MISS. BD. OF WATER COMMISSIONERS

If well telescopes please sketch and show depths.

GROUND LEVEL

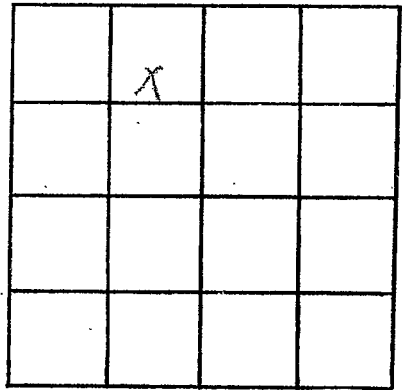

SECTION 3

Please indicate well location X.

ADDITIONAL INFORMATION

If more than one screen, show locations of each on sketch.