

MONROE

Q 2006

6-1-78

MISSISSIPPI BOARD OF WATER COMMISSIONERS

416 North State Street  
Jackson, Mississippi 39201

WATER WELL DRILLERS LOG

6-1-1978 date well completed

Leeper firm name

Monroe county well located

LANDOWNER:

Karen Malone

Rt. 2 Hamilton, Ms  
(mailing address)

description of formations encountered

Top sand  
Clay & lignites  
Sand

from to

0 40  
40 110  
110 135

WELL LOCATION:

sec 24 T 15 N R 9 E 18W

3 1/2 miles E of Hamilton  
(distance) (direction) (nearest town)

WELL PURPOSE: Home  
(home, irrigation, municipal, industrial)

WELL COMPLETION DATA:

- (1) diameter (inches) 4
- (2) total depth (feet) 135
- (3) static water level (feet) 128 below top of ground.

(4) casing PUC, 125  
(material) (depth)

if telescope see back.  
(size)

(5) screen 10' PUC  
(length) (depth to top)

1/2  
(size) (material)

(6) pump 1/2 4  
(HP) (yield gpm)

(7) electric log No  
(yes or no)

(organization running log)

(8) how well bottom plugged Back  
wash valve


DRILLERS REMARKS:

RECEIVED  
AUG 29 1978

MISS. Bd OF WATER COMMISSIONERS

If well telescopes please sketch and show depths.

GROUND LEVEL

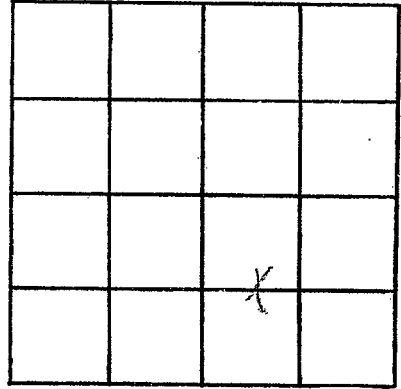

SECTION 24

Please indicate well location X.

ADDITIONAL INFORMATION

If more than one screen, show locations of each on sketch.