

MONROE
Q 2007
8-24-78

**MISSISSIPPI
BOARD OF WATER COMMISSIONERS**
416 North State Street
Jackson, Mississippi 39201

WATER WELL DRILLERS LOG

8-24 1978 Deeper Monroe
 date well completed firm name county well located

LANDOWNER:
Thomas Pugh
Box 61
Hamilton Mo.
 (mailing address)

description of formations encountered	from	to
Top sand	0	60
Sticky clay	60	140
Fine sand	140	150
Blue clay	150	200
Sand + gravel	200	240

WELL LOCATION:
 sec 24 T 15 N R 18 E
3 miles E of Hamilton
 (distance) (direction) (nearest town)

WELL PURPOSE: Home
 (home, irrigation, municipal, industrial)

WELL COMPLETION DATA:

(1) diameter (inches) 4

(2) total depth (feet) 240

(3) static water level (feet) 180 below above top of ground.

(4) casing PVC (material) (depth) _____
 _____ (size) If telescope see back.

(5) screen 10 , 230 (length) (depth to top)
4 , PVC (size) (material)

(6) pump 1/2 (HP) 8 (yield gpm)
Elec (type power)

(7) electric log No (yes or no)
 _____ (organization running log)

(8) how well bottom plugged Back
wash valve


REGISTERED
 OCT 10 1978

DRILLERS REMARKS:

MISS. BD. OF WATER COMMISSIONERS

If well telescopes please sketch and show depths.

GROUND LEVEL

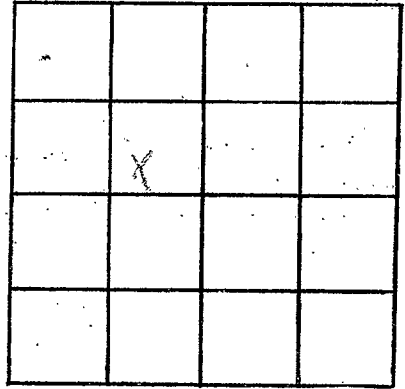

SECTION

Please indicate well location X.

ADDITIONAL INFORMATION

If more than one screen,
show locations of each on sketch.