

MONROE

Q 2008

10-15-78

MISSISSIPPI BOARD OF WATER COMMISSIONERS  
416 North State Street  
Jackson, Mississippi 39201

WATER WELL DRILLERS LOG


Oct 15 1978 Herman Homan Well & Supply Inc. Monroe  
date well completed firm name county well located  
SHANNON MISSISSIPPI

LANDOWNER:	description of formations encountered	from	to
Frank Clark (cont)	surface sand	0	25
Abedeen, Mrs. (mailing address)	clay	25	30
	blue clay	30	35
	sand	35	75
	bottom	75	
<b>WELL LOCATION:</b> sec. 18 T. 15 N R. 19 E W. 2 E 1 1/2 miles SW of Hantle (distance) (direction) (nearest town)			
<b>WELL PURPOSE:</b> Home (home, irrigation, municipal, industrial)			
<b>WELL COMPLETION DATA:</b>			
(1) diameter (inches) 4"			
(2) total depth (feet) 75'			
(3) static water level (feet) 10' below top of ground.			
(4) casing 5" steel 25' 3" (material) (depth) 4" if telescope see back. (size)			
(5) screen 20" (length) (depth to top) (size) (material)			
(6) pump 1/2 HP 5 (HP) (yield gpm) check (type power)			
(7) electric log 20 (yes or no)			
(organization running log)			
(8) how well bottom plugged open			
<b>DRILLERS REMARKS:</b>			

RECEIVED  
NOV - 6 1978  
MISS. Bd. of WATER COMMISSIONERS

If well telescopes please sketch and show depths.

GROUND LEVEL

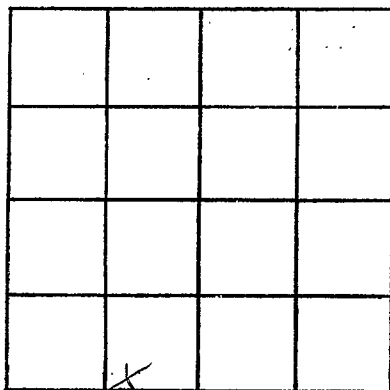

SECTION 18

Please indicate well location X.

ADDITIONAL INFORMATION

If more than one screen, show locations of each on sketch.