

MONROE
Q 209
9-26-78

MISSISSIPPI
BOARD OF WATER COMMISSIONERS
 416 North State Street
 Jackson, Mississippi 39201

WATER WELL DRILLERS LOG

9-26-1978 date well completed Leeper firm name Monroe county well located

LANDOWNER: Richard Campbell
Rt. 2 Box 238
Hamilton, Ms.
 (mailing address)

description of formations encountered	from	to
top clay	0	30
green sand + clay	30	250
sand + small gravel	250	315

WELL LOCATION:
 sec. 12 T. 15 N. R. 2 W.
7 miles E of Hamilton
 (distance) (direction) (nearest town)

WELL PURPOSE: Home
 (home, irrigation, municipal, industrial)

WELL COMPLETION DATA:

- diameter (inches) 4
- total depth (feet) 315
- static water level (feet) 180 ^{below} above top of ground.
- casing PVC, 305
 (material) (depth)
 if telescope see back.
 (size)
- screen 10, 305
 (length) (depth to top)
4, PVC
 (size) (material)
- pump 3/4, 10
 (HP) (yield gpm)
Coles
 (type power)
- electric log No
 (yes or no)

 (organization running log)
- how well bottom plugged Back
wash valve

DRILLERS REMARKS:

description of formations encountered	from	to


Miss. Board of Water Comm.

FEB 16 1979

RECEIVED

If well telescopes please sketch and show depths.

GROUND LEVEL

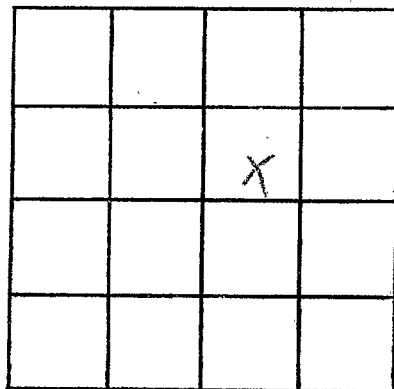

SECTION 12

Please indicate well location X.

ADDITIONAL INFORMATION

If more than one screen, show locations of each on sketch.