

MONROE

MISSISSIPPI
BOARD OF WATER COMMISSIONERS
416 North State Street
Jackson, Mississippi 39201

Q 2010

6/17/80

6-12 date well completed

1980 Martin S. K. Spivey firm name

Monroe county well located

WATER WELL DRILLERS LOG

LANDOWNER: A. G. Sims

description of formations encountered

from to

Hamilton Miss.
(mailing address)

Sandy clay 0 25

WELL LOCATION:

sec. 2 T. 15 N. R. 18 E
5 miles East of Lockport
(distance) (direction) (nearest town)

clay & sand 25 65

sand 65 105

WELL PURPOSE: None
(home, irrigation, municipal, industrial)

clay 105 112

sand 112 125

WELL COMPLETION DATA:

- (1) diameter (inches) 4"
- (2) total depth (feet) 125'
- (3) static water level (feet) 55' below top of ground.
- (4) casing PVC, 105'
(material) (depth)
4" if telescope see back.
(size)
- (5) screen 28', 105'
(length) (depth to top)
4" x 20', PVC
(size) (material)
- (6) pump 1/2, 10
(HP) (yield gpm)
E
(type power)
- (7) electric log
(yes or no)

(organization running log)

(8) how well bottom plugged

DRILLERS REMARKS:


DEPT. OF NATURAL RESOURCES
BUREAU OF LAND & WATER RESOURCES

AUG 11 1980

RECEIVED

If well telescopes please sketch and show depths.

GROUND LEVEL

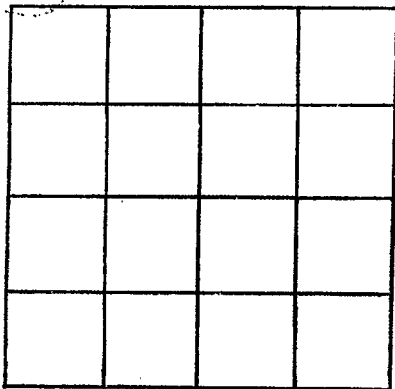

SECTION _____

Please indicate well location X.

ADDITIONAL INFORMATION

If more than one screen, show locations of each on sketch.