

Monroe  
Q 2011

MISSISSIPPI  
 BOARD OF WATER COMMISSIONERS  
 416 North State Street  
 Jackson, Mississippi 39201

WATER WELL DRILLERS LOG

June 9 19 82 Mid South Drilling Company Monroe  
 date well completed firm name county well located


LANDOWNER: Jerry Johncox Rt. 2 Box 243 Hamilton, MS 39746 (mailing address)	description of formations encountered	from	to
	sand	12	45
	clay and sand	45	75
WELL LOCATION: sec. 12 T. 15 N. R. 18 W. S W	sand	75	150
	clay and sand	150	165
	clay	165	208
	sand	208	227
(distance) miles of (direction) of (nearest town)	clay	227	240
WELL PURPOSE: home (home, irrigation, municipal, industrial)	sand	240	278
WELL COMPLETION DATA:			
(1) diameter (inches) 4			
(2) total depth (feet) 278			
(3) static water level (feet) 160 below top of ground.			
(4) casing PVC 256 (material) (depth) 4" (size) If telescope see back.			
(5) screen 22' 256 (length) (depth to top) 4" (size) PVC (material)			
(6) pump 2 30 (HP) (yield gpm) electric (type power)			
(7) electric log no (yes or no) no (organization running log)			
(8) how well bottom plugged screened			
DRILLERS REMARKS:			

DEPT. OF NATURAL RESOURCES  
 BUREAU OF LAND & WATER RESOURCES

SEP 24 1982  
 RECEIVED

If well telescopes please sketch and show depths.

GROUND LEVEL

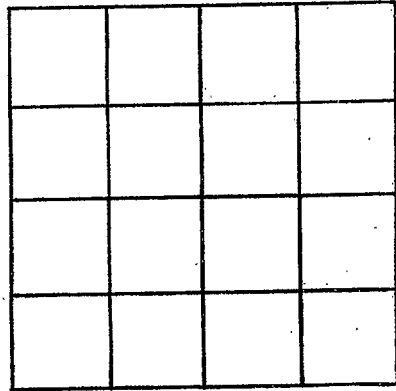

SECTION \_\_\_\_\_

Please indicate well location X.

ADDITIONAL INFORMATION

If more than one screen, show locations of each on sketch.