

Monroe  
Q  
2014

MISSISSIPPI DEPARTMENT OF NATURAL RESOURCES  
 Bureau of Land and Water Resources  
 Southport Mall  
 P.O. Box 10631  
 Jackson, Mississippi 39209  
**WATER WELL DRILLERS LOG**

July 18 19 Clardy Well Drilling Monroe  
 date well completed firm name county well located

LANDOWNER: Tenn. Gas Co.  
720 E. Main St Suite 504  
Houma, La. 70360  
 (mailing address)

description of formations encountered	from	to
<u>grey clay</u>	<u>0</u>	<u>12</u>
<u>light &amp; gravel</u>	<u>12</u>	<u>27</u>
<u>blue clay</u>	<u>27</u>	<u>58</u>
<u>sandy clay</u>	<u>58</u>	<u>68</u>
<u>hard blue clay</u>	<u>68</u>	<u>121</u>
<u>sand</u>	<u>121</u>	<u>182</u>

WELL LOCATION:  
 sec. 6 T. 16 N. R. 17 E.  
10 miles SE of Aberdeen  
 (distance) (direction) (nearest town)

WELL PURPOSE: Industrial  
 (home, irrigation, municipal, industrial)

- WELL COMPLETION DATA:
- (1) diameter (inches) 4"
  - (2) total depth (feet) 182'
  - (3) static water level (feet) 18' below above top of ground.
  - (4) casing PVC 72'  
 (material) (depth)  
4" if telescope see back.  
 (size)
  - (5) screen 30'  
 (length) (depth to top)  
2"  
 (size) (material)
  - (6) pump 1/2 800 gpd.  
 (HP) (yield gpd.)  
elec.  
 (type power)
  - (7) electric log No  
 (yes or no)

(organization running log)

(8) how well bottom plugged

DRILLERS REMARKS:

DEPT. OF NATURAL RESOURCES  
 BUREAU OF LAND & WATER RESOURCES

AUG 22 1983

RECEIVED


If well telescopes please sketch and show depths.

GROUND LEVEL

12' 4"

7' 2"

21 screens

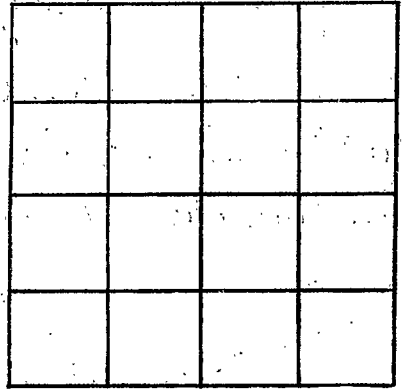

SECTION \_\_\_\_\_

Please indicate well location X:

ADDITIONAL INFORMATION

If more than one screen,  
show locations of each on sketch.