

MISSISSIPPI DEPARTMENT OF NATURAL RESOURCES

Bureau of Land and Water Resources

Southport Mall

P.O. Box 10631

Jackson, Mississippi 39209

WATER WELL DRILLERS LOG

TOM GRIFFITH

PLUMBING & WELL SERVICE, INC. *Monroe*

Monroe
Q 2015

8-6-83 19
date well completed

320 MANSON AVE,
COLUMBIA, MS 39129

county well located

LANDOWNER: *Earl Simmons*

description of formations encountered

from

to

Ret. 1
Hamilton, MS
(mailing address)

Chalk	0'	7'
Pea Gravel	7'	28'
Blue Chalk	28'	35'
Grey Sand	35'	70'
Blue Chalk	70'	90'
Sand & Limestone	90'	189'
Chalk	189'	235'
Sand	235'	270'
Rock	270'	272'
Chalk	272'	280'
Sand	280'	315'

WELL LOCATION:

sec. *21* T. *15* N. R. *8* E. *W*
2 miles *E* of *Hamilton*
(distance) (direction) (nearest town)

WELL PURPOSE: *home*
(home, irrigation, municipal, industrial)

WELL COMPLETION DATA:

- (1) diameter (inches) *4"*
- (2) total depth (feet) *315'*
- (3) static water level (feet) *50'* below above top of ground.
- (4) casing *PVC*, *285'*,
(material) (depth)
N/A If telescope see back.
(size)
- (5) screen *30'*, *285'*
(length) (depth to top)
4", *PVC*
(size) (material)
- (6) pump *1*, *30*
(HP) (yield gpm)
electric
(type power)
- (7) electric log *NO*
(yes or no)
N/A
(organization running log)
- (8) how well bottom plugged *B.W.U.*

DRILLERS REMARKS: *189' shale*
tried - only 5gpm
max. yield.


DEPT. OF NATURAL RESOURCES
BUREAU OF LAND & WATER RESOURCES

DEC 15 1983

RECEIVED

If well telescopes please sketch and show depths.

GROUND LEVEL

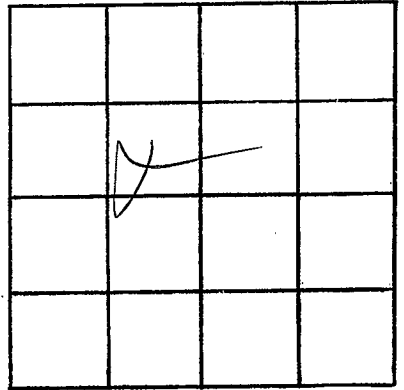

SECTION 21

Please indicate well location X.

ADDITIONAL INFORMATION

If more than one screen, show locations of each on sketch.