

MISSISSIPPI DEPARTMENT OF NATURAL RESOURCES

Bureau of Land and Water Resources

Southport Mall

P.O. Box 10631

Jackson, Mississippi 39209

WATER WELL DRILLERS LOG

TOM GRIFFITH

PLUMBING & WELL SERVICE, INC.

320 MARSHALL AVE.

COLUMBIA, MS 39429

Monroe county well located

Monroe
Q 2016

8-7-83 19
date well completed

LANDOWNER: Tom Judon

Rt. 1

Hamilton, MS
(mailing address)

description of formations encountered

from

to

Clay Gravel

0' 10'

Red Sand

10' 30'

Chalk

30' 55'

Sand

55' 135'

WELL LOCATION:

sec. 33 T 15 N R. 8 E
8 miles E of Aberdeen
(distance) (direction) (nearest town)

WELL PURPOSE: home
(home, irrigation, municipal, industrial)

WELL COMPLETION DATA:

- (1) diameter (inches) 4"
- (2) total depth (feet) 135'
- (3) static water level (feet) 50' below top of ground.
- (4) casing PUC, 115'
(material) (depth)
N/A if telescope see back.
(size)
- (5) screen 20', 115'
(length) (depth to top)
4", PUC
(size) (material)
- (6) pump 1/2, 12
(HP) (yield gpm)
electric
(type power)
- (7) electric log NO
(yes or no)
N/A
(organization running log)
- (8) how well bottom plugged B.W.V.

DEPT. OF NATURAL RESOURCES
BUREAU OF LAND & WATER RESOURCES


DEC 15 1983

RECEIVED

DRILLERS REMARKS:

If well telescopes please sketch and show depths.

GROUND LEVEL

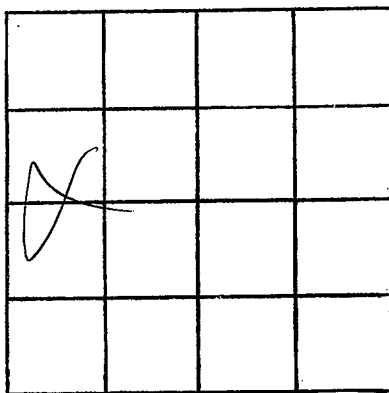

SECTION 32

Please indicate well location X.

ADDITIONAL INFORMATION

If more than one screen,
show locations of each on sketch.