

MISSISSIPPI DEPARTMENT OF NATURAL RESOURCES

Bureau of Land and Water Resources

Southport Mall

P.O. Box 10631

Jackson, Mississippi 39209

WATER WELL DRILLERS LOG

**TOM GRIFFITH**

PLUMBING & WELL SERVICE, INC.

320 MAYSON AVE.

COLUMBIA, MISSISSIPPI 39429

Monroe  
Q 2017

8-11-83  
date well completed

Monroe  
county well located

LANDOWNER: Bobby Waverly

description of formations encountered

from

to

Rt-1

Chalk

0' 10'

Hamilton, MS  
(mailing address)

Sand & Pea Gravel

10' 28'

Chalk

28' 35'

WELL LOCATION:

sand

35' 80'

sec 32 T 16 N R 8 E

Rock

80' 81'

sand

81' 85'

Chalk

85' 90'

6 miles NE of Hamilton  
(distance) (direction) (nearest town)

Sand

90' 130'

WELL PURPOSE: home  
(home, irrigation, municipal, industrial)

WELL COMPLETION DATA:

- (1) diameter (inches) 4"
- (2) total depth (feet) 130'
- (3) static water level (feet) 50' below above top of ground.

(4) casing PVC 110'  
(material) (depth)

N/A if telescope see back.  
(size)

(5) screen 20' 110'  
(length) (depth to top)

4" PVC .01051"  
(size) (material)

(6) pump 1/2 12  
(HP) (yield gpm)

electric  
(type power)

(7) electric log NO  
(yes or no)

N/A  
(organization running log)

(8) how well bottom plugged B.W.U.

DRILLERS REMARKS: Well making fine sand. Inserted 0.006 3" PVC wrapped screen.


DEPT. OF NATURAL RESOURCES  
BUREAU OF LAND & WATER RESOURCES

DEC 15 1983

RECEIVED

If well telescopes please sketch and show depths.

GROUND LEVEL

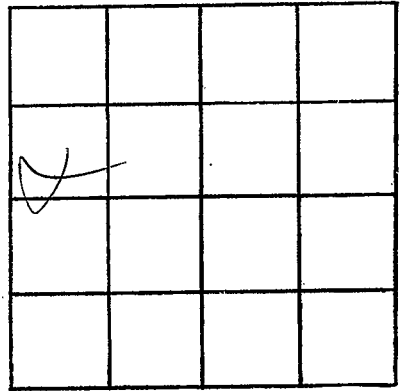

SECTION 32

Please indicate well location X.

ADDITIONAL INFORMATION

If more than one screen,  
show locations of each on sketch.