

Monroe
Q 2018

MISSISSIPPI DEPARTMENT OF NATURAL RESOURCES
 Bureau of Land and Water Resources
 Southport Mall
 P.O. Box 10631

Jackson, Mississippi 39209

WATER WELL DRILLERS LOG
 TOM GRIFFITH

8-20-83

date well completed

PLUMBING & WELL SERVICE, INC.

320 MAYSON AVE.
COLUMBIA, MS 39429

Monroe

county well located

LANDOWNER: Jerry Pittman

Rt-1

Hamilton, MS

(mailing address)

WELL LOCATION:

sec. 32 T 15 N R 8 E

6 miles NE of Hamilton
 (distance) (direction) (nearest town)

WELL PURPOSE: home
 (home, irrigation, municipal, industrial)

WELL COMPLETION DATA:

- (1) diameter (inches) 4"
- (2) total depth (feet) 130'
- (3) static water level (feet) 50' below above top of ground.
- (4) casing PVC, 110',
 (material) (depth)
N/A if telescope see back.
 (size)
- (5) screen 20', 110'
 (length) (depth to top)
4", PVC
 (size) (material)
- (6) pump 1/2, 12
 (HP) (yield gpm)
electric
 (type power)
- (7) electric log NO
 (yes or no)
N/A
 (organization running log)
- (8) how well bottom plugged B.W.D.

description of formations encountered

from

to

<u>Chalk</u>	<u>0'</u>	<u>22'</u>
<u>Sand & Pea Gravel</u>	<u>22'</u>	<u>60'</u>
<u>Chalk</u>	<u>60'</u>	<u>80'</u>
<u>Sand</u>	<u>80'</u>	<u>89'</u>
<u>ROCK</u>	<u>89'</u>	<u>90'</u>
<u>Sand</u>	<u>90'</u>	<u>130'</u>

DEPT. OF NATURAL RESOURCES
 BUREAU OF LAND & WATER RESOURCES
 BUREAU OF LAND & WATER RESOURCES


DEC 15 1983

RECEIVED

DRILLERS REMARKS: Fine Sand
4" x 1/2" - inserted
3" x 1/2" PVC wrapped
Screen.

If well telescopes please sketch and show depths.

GROUND LEVEL

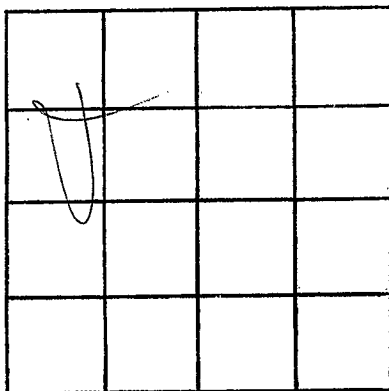

SECTION 32

Please indicate well location X.

ADDITIONAL INFORMATION

If more than one screen,
show locations of each on sketch.