

MONROE
R 4
7-25-72

MISSISSIPPI
 BOARD OF WATER COMMISSIONERS
 416 North State Street
 Jackson, Mississippi 39201

WATER WELL DRILLERS LOG

7-25 1972 W. J. REEVES & SON MONROE
 date well completed firm name county well located

LANDOWNER: FLORIA ADAMS
RT. 1
HAMILTON
 (mailing address)

description of formations encountered	from	to
<u>RED SANDY CLAY</u>	<u>0</u>	<u>22</u>
<u>RED SAND</u>	<u>22</u>	<u>120</u>

WELL LOCATION:
 sec. 6 T. 15 S. R. 22 W.
11 miles E of ABERDEEN
 (distance) (direction) (nearest town)

WELL PURPOSE: HOME
 (home, irrigation, municipal, industrial)


- WELL COMPLETION DATA:
- (1) diameter (inches) 4
 - (2) total depth (feet) 120
 - (3) static water level (feet) 75 below top of ground.
 - (4) casing PVC, 100
 (material) (depth)
4 if telescope see back.
 (size)
 - (5) screen 20, 100
 (length) (depth to top)
4, PVC
 (size) (material)
 - (6) pump _____
 (HP) (yield gpm)
 (type power)
 - (7) electric log NO
 (yes or no)
 (organization running log)
 - (8) how well bottom plugged SAND

DRILLERS REMARKS:

NOV 17 1972
 MISS. BUREAU OF WATER
 JACKSON, MISSISSIPPI

If well telescopes please sketch and show depths.

GROUND LEVEL

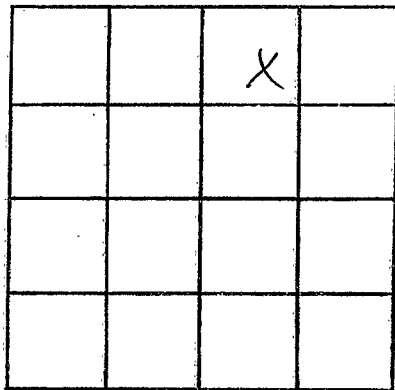

SECTION 6

Please indicate well location X.

ADDITIONAL INFORMATION

If more than one screen,
show locations of each on sketch.