

CODED

DEC 18 1968

MISSISSIPPI BOARD OF WATER COMMISSIONERS  
416 North State Street  
Jackson, Mississippi 39201

MISS. BD. OF WATER COMM.

WATER WELL DRILLERS LOG

CODED

Monroe  
R 8  
7-268

7-2 date well completed 1968 firm name *Martin S. Ridgeway* county well located *Monroe*

LANDOWNER: *Harry Grant*

description of formations encountered from to

*Caldonia miss*

*0-18 Clay* 0 18

(mailing address)

*land + gravel* 18 27

WELL LOCATION:


sec. *21* T. *15* N. R. *17* E.  
*6* miles *north* of *Caldonia*  
(distance) (direction) (nearest town)

WELL PURPOSE: *oil well location*  
(home, irrigation, municipal, industrial)

WELL COMPLETION DATA:


- (1) diameter (inches) *4"*
- (2) total depth (feet) \_\_\_\_\_
- (3) static water level (feet) *10* below above top of ground.
- (4) casing *4 1/2" steel*, *47'*  
(material) (depth)
- \_\_\_\_\_ if telescope see back.  
(size)
- (5) screen \_\_\_\_\_, \_\_\_\_\_  
(length) (depth to top)
- \_\_\_\_\_ , \_\_\_\_\_  
(size) (material)
- (6) pump \_\_\_\_\_, \_\_\_\_\_  
(HP) (yield gpm)
- \_\_\_\_\_ (type power)
- (7) electric log *no*  
(yes or no)
- \_\_\_\_\_ (organization running log)
- (8) how well bottom plugged \_\_\_\_\_

DRILLERS REMARKS:

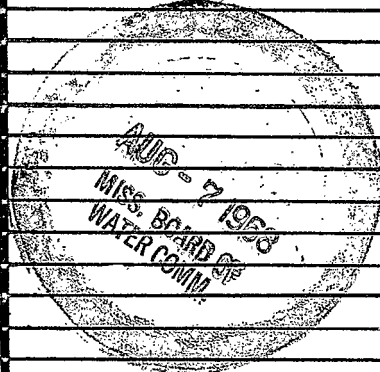

If well telescopes please sketch and show depths.

GROUND LEVEL

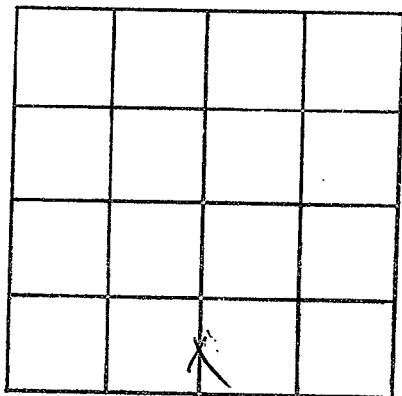

SECTION \_\_\_\_\_

Please indicate well location X.

ADDITIONAL INFORMATION

well is located on  
Harry Grant Farm 6 mi  
north Caledonia Miss  
14.00 feet from ~~potato~~  
Katahatche river  
at oil well location  
oil well drilled by  
occidental oil co.  
of ~~Jeff~~ Lafayette La.

If more than one screen,  
show locations of each on sketch.