

MISSISSIPPI DEPARTMENT OF NATURAL RESOURCES

Bureau of Land and Water Resources

Southport Mall

P.O. Box 10631

Jackson, Mississippi 39209

WATER WELL DRILLERS LOG

CODED

R12  
 MONROE  
 1-14-84

1-14-84

Griner Drilling Service, Inc.

Monroe

date well completed

firm name

county well located

LANDOWNER:

TXO Production  
 Suite 555  
 111 Capital Building  
 JACKSON, Miss. 39201

description of formations encountered

from

to

fill	0	21
chalk, rock	21	189
chalk	189	252
sand	252	336

WELL LOCATION:

990' S & 1300' W  
 sec. 17 T 15 N R 12 E NE/4  
 No. 17-2 Cedar Grove Field  
 (distance) miles (direction) of (nearest town)

WELL PURPOSE: oil field supply  
 (home, irrigation, municipal, industrial)

WELL COMPLETION DATA:

- (1) diameter (inches) 3"
- (2) total depth (feet) 336'
- (3) static water level (feet) 100' below top of ground.
- (4) casing steel, 336' (material), (depth)
- 3" (size) if telescope see back.
- (5) screen 42', 294' (length), (depth to top)
- 3", perforated (size), (material)
- (6) pump 50 (HP), (yield gpm)
- AC (type power)
- (7) electric log (yes or no)

CODED

DEPT. OF NATURAL RESOURCES  
 BUREAU OF LAND & WATER RESOURCES

JAN 23 1984


RECEIVED

DRILLERS REMARKS:

orange peel

If well telescopes please sketch and show depths.

GROUND LEVEL

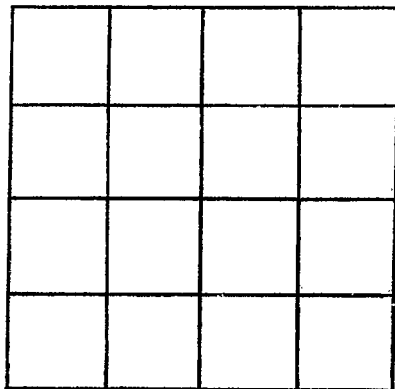

SECTION \_\_\_\_\_

Please indicate well location X.

ADDITIONAL INFORMATION

If more than one screen, show locations of each on sketch.