

Monroe
R 2001
4-27-76

MISSISSIPPI
 BOARD OF WATER COMMISSIONERS
 416 North State Street
 Jackson, Mississippi 39201


WATER WELL DRILLERS LOG

4-27 1976 W. J. REEVES & SON MONROE
 date well completed firm name county well located

LANDOWNER: <u>SARAH NAIL</u>	description of formations encountered	from	to
<u>HAMILTON</u>			
(mailing address)	<u>OPEN CLAY</u>	<u>0</u>	<u>20</u>
	<u>" SAND</u>	<u>20</u>	<u>100</u>
WELL LOCATION:			
sec. <u>6</u> T. <u>15</u> N. R. <u>17</u> E			
<u>10</u> miles <u>SE</u> of <u>ABERDEEN</u>			
(distance) (direction) (nearest town)			
WELL PURPOSE: <u>HOME</u>			
(home, irrigation, municipal, industrial)			
WELL COMPLETION DATA:			
(1) diameter (inches) <u>4</u>			
(2) total depth (feet) <u>100</u>			
(3) static water level (feet) <u>67</u> below/above top of ground.			
(4) casing <u>PVC</u> , <u>80</u> , (material) (depth)			
<u>4</u> if telescope see back. (size)			
(5) screen <u>20</u> , <u>80</u> (length) (depth to top)			
<u>4</u> , <u>PVC</u> (size) (material)			
(6) pump <u>1/2</u> , <u>7</u> (HP) (yield gpm)			
<u>ELECT</u> (type power)			
(7) electric log <u>No</u> (yes or no)			
(organization running log)			
(8) how well bottom plugged <u>SAND</u>			
DRILLERS REMARKS:			

If well telescopes please sketch and show depths.

GROUND LEVEL

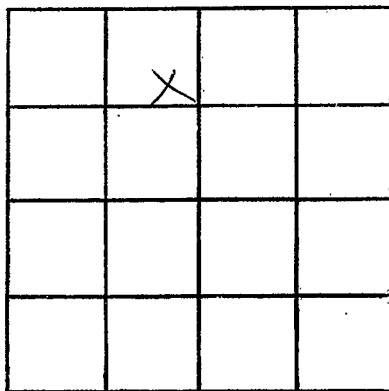

SECTION 6

Please indicate well location X.

ADDITIONAL INFORMATION

If more than one screen, show locations of each on sketch.