

Monroe  
R 2005

MISSISSIPPI  
BOARD OF WATER COMMISSIONERS  
416 North State Street  
Jackson, Mississippi 39201

WATER WELL DRILLERS LOG

10-22 1982 Martin S. Redding Monroe  
date well completed firm name county well located

LANDOWNER: Arnold Owens  
Box 244  
Hamilton MS. 39746  
(mailing address)

description of formations encountered	from	to
	<u>clay</u>	<u>0</u>
<u>clay</u>	<u>50</u>	<u>68</u>
<u>clay &amp; sand</u>	<u>68</u>	<u>130</u>

WELL LOCATION:  
sec. 16 T. 15 N. R. 17 E.  
S. W.  
3 miles NE of Hamilton MS.  
(distance) (direction) (nearest town)

WELL PURPOSE: None  
(home, irrigation, municipal, industrial)

- WELL COMPLETION DATA:
- (1) diameter (inches) 4
  - (2) total depth (feet) 130
  - (3) static water level (feet) 68 below/above top of ground.
  - (4) casing PVC, 130'  
(material) (depth)  
4" If telescope see back.  
(size)
  - (5) screen 10, 130'  
(length) (depth to top)  
4, PVC  
(size) (material)
  - (6) pump None  
(HP) (yield gpm)  
  
(type power)
  - (7) electric log no  
(yes-or no)  
  
(organization running log)
  - (8) how well bottom plugged \_\_\_\_\_

DRILLERS REMARKS: \_\_\_\_\_


DEPT. OF NATURAL RESOURCES  
BUREAU OF LAND & WATER RESOURCES

JUL 14 1982

RECEIVED

If well telescopes please sketch and show depths.

GROUND LEVEL

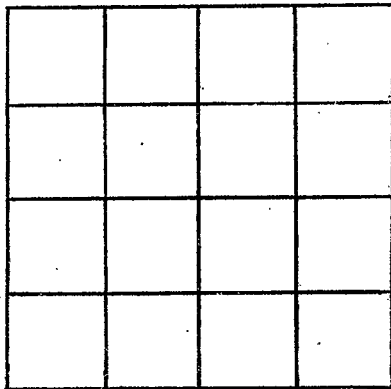

SECTION \_\_\_\_\_

Please indicate well location X.

ADDITIONAL INFORMATION

If more than one screen, show locations of each on sketch.