

MISSISSIPPI DEPARTMENT OF ENVIRONMENTAL QUALITY
Bureau of Land and Water Resources

P. O. Box 10631
Jackson, MS 39289-0631
WATER WELL DRILLERS LOG

COUNTY WELL LOCATED <u>Monroe</u>	
WELL NUMBER <u>R 2006</u>	CODED
DATE WELL COMPLETED <u>09/04/90</u>	

PERMIT NUMBER
NAME OF DRILLING FIRM <u>Herndon Well & Supply</u>
<u>Shannon, MS 38868</u>

NAME & MAILING ADDRESS OF LANDOWNER <u>W. H. Barnett</u>			
<u>207 West Monroe St</u>			
<u>Aberdeen, MS 39730</u>			
WELL LOCATION:	SEC	TOWNSHIP	RANGE
	<u>23</u>	<u>15</u>	<u>S 7 E</u>
DISTANCE	DIRECTION	NEAREST TOWN	
<u>5</u> Miles	<u>S</u>	of <u>Aberdeen</u>	
OTHER LANDMARK			
WELL PURPOSE: Home, Irrigation, Municipal, Industrial, Fish Pond, etc. <u>Home</u>			

PUMP DATA		
PUMP TYPE (Circle One): <u>3/4hp</u>		
<input checked="" type="checkbox"/> Submersible	Turbine,	Jet Flowing Well,
Other (Describe) _____		
POWER TYPE (Circle One):		
<input checked="" type="checkbox"/> Electric	Tractor,	Gasoline, Butane,
Other (Describe) _____ H/P _____		
Pump Capacity (GPM)	No. of Stages	Setting Depth
<u>7</u>	<u>15</u>	<u>180</u> FT.
PUMP TEST		
Well yielded _____ GPM with		
a drawdown of _____ ft.		
after _____ hours of pumping		

WELL DATA		
Well Depth <u>260'</u>	Casing Diameter (In.) <u>4"</u>	Casing Length (Ft.) <u>240'</u>
Type of Casing <u>PVC</u>	Hole Depth <u>260'</u>	Depth to Static Water Level
TYPE OF COMPLETION: (Circle One or More):		
<input checked="" type="checkbox"/> Gravel Packed	<input type="checkbox"/> Underreamed,	<input type="checkbox"/> Telescoped,
<input type="checkbox"/> Natural Development,	<input type="checkbox"/> Open Hole,	<input type="checkbox"/> Other
(Describe) _____		
Top of Lap Pipe or Reduction in Casing		
FEET	IF TELESCOPED OR MORE THAN ONE SCREEN: USE BACK PAGE	

LOG DATA	
TYPE OF LOG RUN (Circle One): <input checked="" type="checkbox"/> <u>No Log Run</u>	
Electric, Gamma Ray, Density, Sonic, Neutron, Other (Describe) _____	
Name of Organization Running Log	

SCREEN DATA		
Diameter - Inches <u>4"</u>	Length - Feet <u>20'</u>	Slot Size - Inches
Screen Type <u>PVC</u>	Depth to Bottom - Feet <u>260'</u>	


GEOLOGIC DATA (Office Use Only)			
Surface Elev.	Geologic Unit	Unit Thickness	Depth to Top
Subs. SWL	Date	Analysis	Aquifer Test
Driller's Remarks			

DESCRIPTION OF FORMATIONS ENCOUNTERED	FROM	TO	FORMATIONS (Continued) FROM	TO
Red Sand	0	4		
White Clay	4	18		
White Sand	18	50		
Blue Sandy Clay	50	145		
Sand	145	185		
Blue Clay	185	210		
Sand	210	260		

IF MORE SPACE IS NEEDED, USE BACK

If well telescopes please
sketch and show depths.

GROUND LEVEL

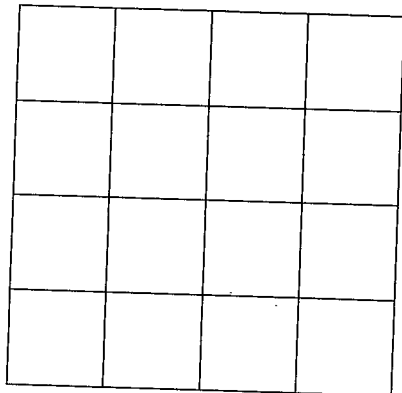

SECTION 23

Please indicate well location X.

ADDITIONAL INFORMATION

If more than one screen,
show location of each on sketch.