

MISSISSIPPI DEPARTMENT OF ENVIRONMENTAL QUALITY

Office of Land and Water Resources

P. O. Box 10631  
Jackson, MS 39289-0631  
WATER WELL DRILLERS LOG

COUNTY WELL LOCATED <i>Monroe</i>
WELL NUMBER CODED <i>R 2008</i>
DATE WELL COMPLETED <i>3-18-99</i>

PERMIT NUMBER <i>0-509</i>
NAME OF DRILLING FIRM <i>Rossi Drilling</i>

NAME & MAILING ADDRESS OF LANDOWNER <i>Green Flippo</i>		
<i>40289 Burks Rd.</i>		
<i>Hamilton MS, 39746</i>		
WELL LOCATION: SEC	TOWNSHIP	RANGE
<i>18</i>	<i>155 N</i>	<i>17 E</i>
DISTANCE	DIRECTION	NEAREST TOWN
_____ Miles	_____ of	_____
OTHER LANDMARK		
WELL PURPOSE: <u>Home</u> , Irrigation, Municipal, Industrial, Fish Pond, etc.		

PUMP DATA		
PUMP TYPE (Circle One): Submersible, Turbine, Jet, Flowing Well, Other (Describe) _____		
POWER TYPE (Circle One): Electric, Tractor, Diesel, Gasoline, Butane, Other (Describe) _____ H/P _____		
Pump Capacity (GPM)	No. of Stages	Setting Depth _____ FT.
PUMP TEST		
Well yielded _____ GPM with a drawdown of _____ ft. after _____ hours of pumping		

WELL DATA		
Well Depth <i>216'</i>	Casing Diameter (In.) <i>4"</i>	Casing Length (Ft.) <i>206'</i>
Type of Casing <i>PVC</i>	Hole Depth	Depth to Static Water Level <i>160</i>

TYPE OF COMPLETION: (Circle One or More):  
 Gravel Packed,     Underreamed,     Telescoped,  
 Natural Development,     Open Hole,     Other  
 (Describe) \_\_\_\_\_

WELL GROUTED TO A DEPTH OF \_\_\_\_\_ FEET  
 Type Grout (circle one): Cement, Bentonite, or Mix

SCREEN DATA		
Diameter - Inches <i>4"</i>	Length - Feet <i>10'</i>	Slot Size - Inches <i>1010</i>
Screen Type <i>PVC</i>	Depth to Bottom - Feet	

LOG DATA	
TYPE OF LOG RUN (Circle One): No Log Run, Electric, Gamma Ray, Density, Sonic, Neutron, Other (Describe) <u>None</u>	
Name of Organization Running Log <u>None</u>	

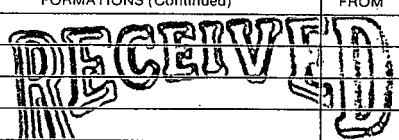
GEOLOGIC DATA (Office Use Only)			
Surface Elev.	Geologic Unit	Unit Thickness	Depth to Top
Subs. SWL	Date	Analysis	Aquifer Test

Driller's Remarks

Top of Lap Pipe or Reduction in Casing

FEET  IF TELESCOPED OR MORE THAN ONE SCREEN: USE BACK PAGE

DESCRIPTION OF FORMATIONS ENCOUNTERED	FROM	TO
<i>Clay</i>	<i>0</i>	<i>36</i>
<i>Sand and Gravel</i>	<i>36</i>	<i>90</i>
<i>Clay</i>	<i>90</i>	<i>190</i>
<i>Sand and Gravel</i>	<i>190</i>	<i>216</i>

FORMATIONS (Continued)	FROM	TO
 <b>JUL 02 1999</b>		
Dept of Environmental Quality Office of Land & Water Resources		

IF MORE SPACE IS NEEDED, USE BACK

If well telescopes please  
sketch and show depths.

GROUND LEVEL


SECTION \_\_\_\_\_

Please indicate well location X.

ADDITIONAL INFORMATION

If more than one screen,  
show location of each on sketch.