

Montgomery
A 19
4-17-69

MISSISSIPPI
BOARD OF WATER COMMISSIONERS
416 North State Street
Jackson, Mississippi 39201

CODED

WATER WELL DRILLERS LOG

4-17 1969
date well completed

Charles Latham
firm name

Montgomery
county well located

LANDOWNER:

Rev - *Wester*

description of formations encountered

from to

Rt 2 Duck Hill Miss
(mailing address)

Red clay	0	10
Blue Soapstone	10	168
Blue Sand	168	198

WELL LOCATION:

sec. 25 T 21 N R 6 E
S
5 miles W of Alva
(distance) (direction) (nearest town)

WELL PURPOSE: *home*
(home, irrigation, municipal, industrial)

WELL COMPLETION DATA:

- (1) diameter (inches) 4"
- (2) total depth (feet) 198'
- (3) static water level (feet) 59' ^{below} _{above} top of ground.
- (4) casing Plastic, 120'
(material) (depth)

(size) If telescope see back.

- (5) screen (length) (depth to top)

(size) (material)

- (6) pump 7/4 6
(HP) (yield gpm)

Electric
(type power)

- (7) electric log NA
(yes or no)

(organization running log)

- (8) how well bottom plugged Open


DRILLERS REMARKS:

JUN 4 - 1969

MISS. BD. OF
WATER COMM.

If well telescopes please sketch and show depths.

GROUND LEVEL

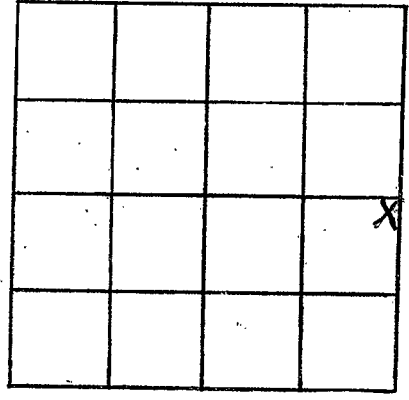

SECTION 25NE

Please indicate well location X.

ADDITIONAL INFORMATION

A series of horizontal lines for writing additional information.

If more than one screen, show locations of each on sketch.