

CODED

MISSISSIPPI  
BOARD OF WATER COMMISSIONERS  
416 North State Street  
Jackson, Mississippi 39201

11/2/69  
3/24/69

Montgomery  
A22  
11-29-68

WATER WELL DRILLERS LOG

Nov 29 19 68 date well completed  
Luther Ralby, Montgomery firm name  
Montgomery county well located

LANDOWNER: Powell Lott  
Wicks Hill  
Mississippi  
(mailing address)

description of formations encountered	from	to
top soil	0	25
sand	25	113
clay	113	183
shale	183	383
sand	383	403
shale	403	443
sand	443	511

WELL LOCATION:  
sec ~~24~~ T 21 N R 5 E  
2 1/2 miles N.E. of Wicks Hill  
(distance) (direction) (nearest town)

WELL PURPOSE: Home  
(home, irrigation, municipal, industrial)

WELL COMPLETION DATA:  
(1) diameter (inches) 4 1/2"  
(2) total depth (feet) 51'  
(3) static water level (feet) 15' below top of ground.  
(4) casing Galv. 5' (material) (depth)  
4 1/2" (size) if telescope see back.  
(5) screen 20' (length) 491 (depth to top)  
2" (size) Stainless (material)  
(6) pump L.H.P. 30 (HP) (yield gpm)  
E. Electric (type power)  
(7) electric log No (yes or no)  
(organization running log)

(8) how well bottom plugged Lock wash valves

DRILLERS REMARKS:

JAN - 9 1969

MISS. DIV. OF  
WATER CONTROL

If well telescopes please sketch and show depths.

GROUND LEVEL

4' x 2"


105 feet  
4" Pipe

486 feet  
2" Pipe

20 feet  
2"

Screen

511 feet

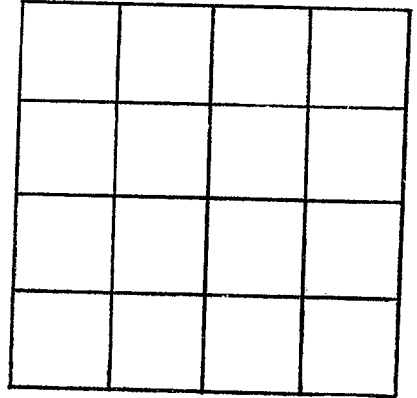

SECTION 24

Please indicate well location X.

ADDITIONAL INFORMATION

If more than one screen,  
show locations of each on sketch.