

MONTGOMERY
A 25

9-72

MISSISSIPPI
BOARD OF WATER COMMISSIONERS
416 North State Street
Jackson, Mississippi 39201

CODED

WATER WELL DRILLERS LOG

Sept
date well completed

1972 Jack Washed Hill Sew
firm name

Montgomery
county well located

LANDOWNER:	description of formations encountered	from	to
<u>Morris Browning</u>	<u>Clay</u>	<u>0</u>	<u>15</u>
<u>Duck Hill</u> (mailing address)	<u>Sand</u>	<u>15</u>	<u>141</u>

WELL LOCATION:
 sec 29 T 21 N R 6 E
2M-N+1/2E miles NW of Duck Hill
 (distance) (direction) (nearest town)

WELL PURPOSE: None
 (home, irrigation, municipal, industrial)


- WELL COMPLETION DATA:
- (1) diameter (inches) 4
- (2) total depth (feet) 136
- (3) static water level (feet) 21 below above top of ground.
- (4) casing Plastic 104
 (material) (depth)
- 4 If telescope see back.
 (size)
- (5) screen 22 104
 (length) (depth to top)
- 4 Plastic
 (size) (material)
- (6) pump 1 30
 (HP) (yield gpm)
- Elec
 (type power)
- (7) electric log No
 (yes or no)
- (organization running log)
- (8) how well bottom plugged cap

DRILLERS REMARKS:

10/1 26 1972
 MISS. DIV. OF
 WATER CONTROL

If well telescopes please
sketch and show depths.

GROUND LEVEL

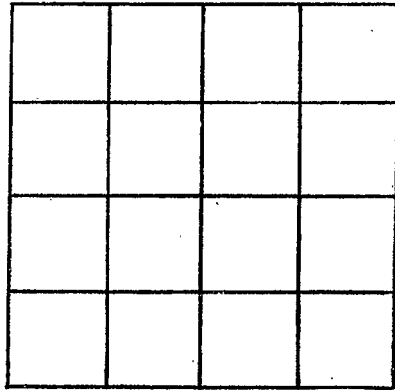

SECTION _____

Please indicate well location X.

ADDITIONAL INFORMATION

If more than one screen,
show locations of each on sketch.