

MONTGOMERY
A28

MISSISSIPPI
BOARD OF WATER COMMISSIONERS
416 North State Street
Jackson, Mississippi 39201

CODED

7/74

WATER WELL DRILLERS LOG

date well completed

firm name

county well located

Yelver Collyer & Sons Montgomery

LANDOWNER:

W.E. Daly
Duckhill, Miss.

description of formations encountered

from

to

Top Soil	0	29
Sand	29	37
Clay	37	107
Sand	107	130
Clay	130	485
Sand	485	610

(mailing address)

WELL LOCATION:

sec. 36 T 21 N R 5 E
1 miles North of Duckhill
(distance) (direction) (nearest town)

WELL PURPOSE: none
(home, irrigation, municipal, industrial)

WELL COMPLETION DATA:

CODED

- (1) diameter (inches) 4 1/2"
- (2) total depth (feet) 310'
- (3) static water level (feet) 30' below above top of ground.
- (4) casing 4 1/2 galv 490' (material) (depth)
- 4 1/2 (size) if telescope see back.
- (5) screen 20' 490' (length) (depth to top)
- 2" stainless steel (size) (material)
- (6) pump 1 HP 18 gal (HP) (yield/gpm)
- electrically (type power)
- (7) electric log no (yes or no)

(organization running log)

(8) how well bottom plugged Wash valve

RECEIVED


JUL 12 1974

DRILLERS REMARKS:

MISS. RD. OF WATER COMM.

If well telescopes please sketch and show depths.

GROUND LEVEL

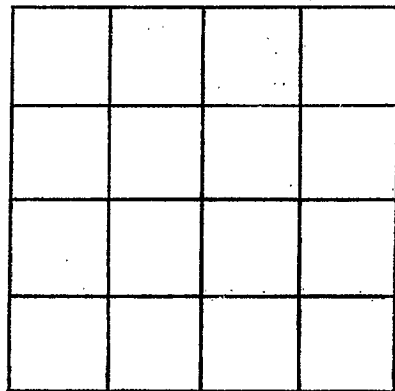

SECTION _____

Please indicate well location X.

ADDITIONAL INFORMATION

If more than one screen,
show locations of each on sketch.