

Montgomery
 A 2000
 9-27-76

MISSISSIPPI ~~Water~~
 BOARD OF WATER COMMISSIONERS
 416 North State Street
 156 Jackson, Mississippi 39201

WATER WELL DRILLERS LOG

9-27 1976 Lipe Well Co. Montgomery
 date well completed firm name county well located


LANDOWNER:	description of formations encountered	from	to
Mr. Vaughn		Top Soil	0
Duck Hill MS.	Sand	20	40
(mailing address)	black clay	40	100
WELL LOCATION:	Clay and sand	100	160
sec. 23 T 21 N S R 5 E W	4 " "	160	200
miles (distance) of (direction) of (nearest town)	4 " "	200	220
WELL PURPOSE:	good sand	220	280
(home irrigation, municipal, industrial)			
WELL COMPLETION DATA:			
(1) diameter (inches) 4			
(2) total depth (feet) 280			
(3) static water level (feet) 20 below top of ground.			
(4) casing PVC 270 (material) (depth)			
4 (size) If telescope see back.			
(5) screen 10 270 (length) (depth to top)			
4 (size) PVC (material)			
(6) pump 3/4 10 (HP) (yield gpm)			
elec. (type power)			
(7) electric log NO (yes or no)			
(organization running log) NO			
(8) how well bottom plugged PVC CAP			
DRILLERS REMARKS:			

RECEIVED

OCT 26 1976

If well telescopes please sketch and show depths.

GROUND LEVEL

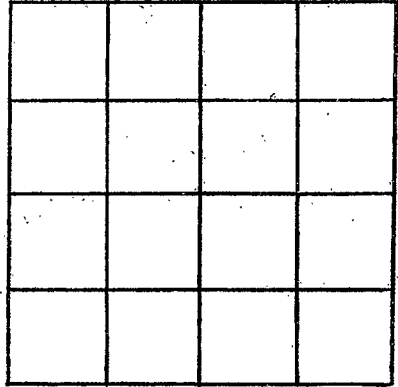

SECTION _____

Please indicate well location X.

ADDITIONAL INFORMATION

If more than one screen, show locations of each on sketch.