

No MAP

~~Water~~
~~Supply~~

MISSISSIPPI
BOARD OF WATER COMMISSIONERS
416 North State Street
Jackson, Mississippi 39201

WATER WELL DRILLERS LOG

MONTGOMERY
A 2002
3-30-79

3/30 1979 Lipe Well Co Montgomery
date well completed firm name county well located

LANDOWNER:
A. P. Rodgers
Duck Hill
(mailing address)

description of formations encountered	from	to
Top Soil	0	20
red sand	20	40
10 2'	40	100
clay	100	120
"	120	160
sand and clay	160	180
good sand	180	220

WELL LOCATION:
sec 28 T 21 N R 5 E
S W
4 miles West of Duck Hill
(distance) (direction) (nearest town)

WELL PURPOSE:
(home, irrigation, municipal, industrial)

- WELL COMPLETION DATA:
- (1) diameter (inches) 4
 - (2) total depth (feet) 220
 - (3) static water level (feet) 105 below top of ground.
 - (4) casing PVC 210 (material), (depth)
 - 4 (size) if telescope see back.
 - (5) screen 10 210 (length), (depth to top)
 - 4 PVC (size), (material)
 - (6) pump 3/4 10 (HP), (yield gpm)
 - elec. (type power)
 - (7) electric log no (yes or no)
 - no (organization running log)
 - (8) how well bottom plugged PVC cap

Miss. Board of Water Comm.


MAY 29 1979

RECEIVED

DRILLERS REMARKS:

If well telescopes please sketch and show depths.

GROUND LEVEL

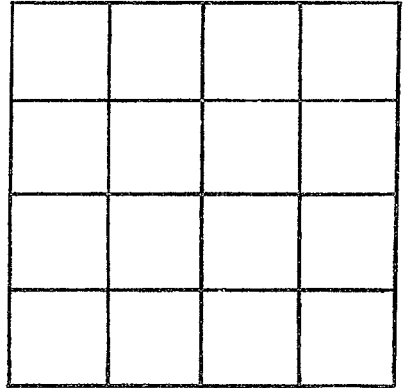

SECTION _____

Please indicate well location X.

ADDITIONAL INFORMATION

If more than one screen, show locations of each on sketch.