

Montgomery
A 2003
10-20-79

MISSISSIPPI
 BOARD OF WATER COMMISSIONERS
 416 North State Street
 Jackson, Mississippi 39201

WATER WELL DRILLERS LOG

10-20
 date well completed

1979 Life Well Co.
 firm name

Montgomery
 county well located

LANDOWNER:
L. L. Branscomb
Duck Hill MS.
 (mailing address)

WELL LOCATION:
 sec. 25 T. 21 N. R. 5 E.
 S W
1 miles North of Duck Hill
 (distance) (direction) (nearest town)

WELL PURPOSE:
 (home, irrigation, municipal, industrial)

WELL COMPLETION DATA:

- (1) diameter (inches) 4
- (2) total depth (feet) 460
- (3) static water level (feet) 50 below top of ground.
- (4) casing PVC 405
 (material) (depth)
4 if telescope see back.
 (size)
- (5) screen 20 440
 (length) (depth to top)
2" PVC
 (size) (material)
- (6) pump 2 1/2 25
 (HP) (yield gpm)
elec.
 (type power)
- (7) electric log No
 (yes or no)
NO
 (organization running log)

description of formations encountered	from	to
TOP soil	0	20
sand	20	40
"	40	80
clay	80	100
"	100	120
sand and clay	120	160
clay	160	200
sand and clay	200	280
" " "	280	300
" " "	300	340
sand	340	360
clay	360	380
sand and clay	380	400
" " "	400	420
sand	420	460

DEPT. OF NATURAL RESOURCES
 BUREAU OF LAND & WATER RESOURCES


NOV - 6 1979

RECEIVED

DRILLERS REMARKS: PVC Plug

If well telescopes please sketch and show depths.

GROUND LEVEL

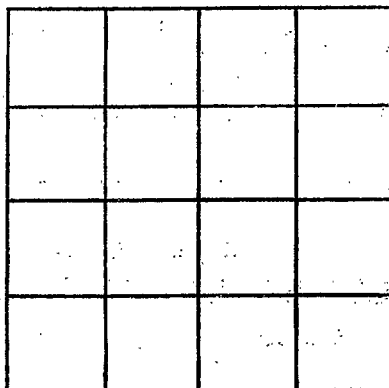

SECTION _____

Please indicate well location X.

ADDITIONAL INFORMATION

If more than one screen, show locations of each on sketch.