

MISSISSIPPI DEPARTMENT OF NATURAL RESOURCES

Bureau of Land and Water Resources

Southport Mall

P.O. Box 10631

Jackson, Mississippi 39209

WATER WELL DRILLERS LOG

Montgomery  
A  
2005

7-11 1984 Thomast Son Montgomery Co  
 date well completed firm name county well located

LANDOWNER: EARNEST ABIL  
Duck Hill Miss  
 (mailing address)

description of formations encountered	from	to
<u>Red Dirt</u>	<u>0</u>	<u>48</u>
<u>Red Chalk</u>	<u>4</u>	<u>8</u>
<u>Calay Chalk</u>	<u>8</u>	<u>20</u>
<u>White Sand</u>	<u>20</u>	<u>48</u>

WELL LOCATION:  
 sec. 31 T. 24 N. R. 4 E  
1 miles NE of Duck Hill  
 (distance) (direction) (nearest town)

WELL PURPOSE:  
 (home, irrigation, municipal, industrial)

WELL COMPLETION DATA:

(1) diameter (inches) 2"

(2) total depth (feet) 48'

(3) static water level (feet) 16' <sup>below</sup> <sub>above</sub> top of ground.

(4) casing PVC, 48'  
 (material) (depth)  
2" if telescope see back.  
 (size)

(5) screen 10', 38'  
 (length) (depth to top)  
2", PVC  
 (size) (material)

(6) pump 1, 10  
 (HP) (yield gpm)  
Electric  
 (type power)

(7) electric log NU  
 (yes or no)  
 (organization running log)

(8) how well bottom plugged Screen

DRILLERS REMARKS:


DEPT. OF NATURAL RESOURCES  
 BUREAU OF LAND & WATER RESOURCES

AUG 9 1984

RECEIVED

If well telescopes please sketch and show depths.

GROUND LEVEL

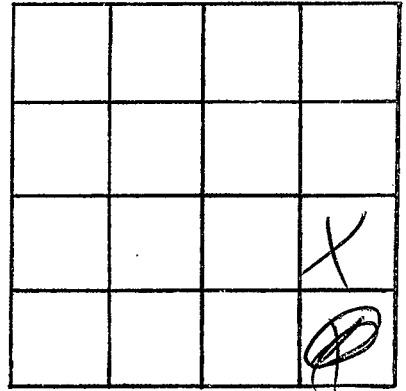

SECTION \_\_\_\_\_

Please indicate well location X.

ADDITIONAL INFORMATION

If more than one screen,  
show locations of each on sketch.