

Montgomery
B 1
5-17-72

MISSISSIPPI
BOARD OF WATER COMMISSIONERS
416 North State Street
Jackson, Mississippi 39201

WATER WELL DRILLERS LOG

5-17 1972 Thomas E. Bond Montgomery
date well completed firm name county well located

LANDOWNER: Jimmy Vance
Duck Hill, Miss.
(mailing address)

description of formations encountered	from	to
<u>Dist</u>	<u>0</u>	<u>16</u>
<u>SAND & Chalk</u>	<u>16</u>	<u>50</u>
<u>Green Chalk & SAND</u>	<u>50</u>	<u>79</u>
<u>Soft Rock</u>	<u>78</u>	<u>79</u>
<u>Black Polished Green Chalk</u>	<u>79</u>	<u>105</u>
<u>Rock 4" to</u>	<u>105</u>	
<u>Green SAND</u>		<u>111</u>
<u>Green-Blue SAND</u>		<u>214</u>
<u>Fine Greenish SAND</u>	<u>214</u>	<u>216</u>
<u>Mostly Green Chalk</u>	<u>216</u>	<u>280</u>
<u>with little silt SAND</u>		
<u>Pure Greenish SAND</u>	<u>280</u>	<u>305</u>
<u>Hard lignite</u>	<u>305</u>	<u>306</u>

WELL LOCATION:
sec. 27 T. 21 N. R. 7 E
3 miles NW of ALVA
(distance) (direction) (nearest town)

WELL PURPOSE:
(home, irrigation, municipal, industrial)

- WELL COMPLETION DATA:
- (1) diameter (inches) 2
 - (2) total depth (feet) 306
 - (3) static water level (feet) 40 ^{below} above top of ground.
 - (4) casing PAV. 210
(material) (depth)
2 if telescope see back.
(size)
 - (5) screen open
(length) (depth to top)
(size) (material)
 - (6) pump 1 10
(HP) (yield gpm)
elec
(type power)
 - (7) electric log NO
(yes or no)
(organization running log)
 - (8) how well bottom plugged open

DRILLERS REMARKS:


CODED

JUL 8 1972

MISS. BD. OF
WATER COMM

If well telescopes please sketch and show depths.

GROUND LEVEL

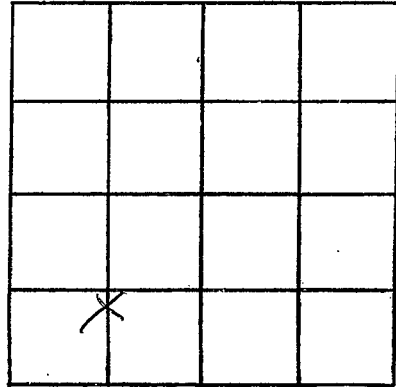

SECTION 27

Please indicate well location X.

ADDITIONAL INFORMATION

Lined area for additional information.

If more than one screen, show locations of each on sketch.