

MONTGOMERY
B 3
9-24-73

MISSISSIPPI
 BOARD OF WATER COMMISSIONERS
 416 North State Street
 Jackson, Mississippi 39201

WATER WELL DRILLERS LOG

Mont

9-24 1973
 date well completed

THOMAS + SON
 firm name

county well located

LANDOWNER: Henned Johnson

Montgomery County
 Duck Hill, Miss.
 (mailing address)

WELL LOCATION:

sec. 30 21 N R. 7 E
7 miles NE of Duck Hill
 (distance) (direction) (nearest town)

WELL PURPOSE: home
 (home, irrigation, municipal, industrial)

WELL COMPLETION DATA:

- (1) diameter (inches) 2
- (2) total depth (feet) 335
- (3) static water level (feet) 4' below above top of ground.
- (4) casing Galv. 231
 (material) (depth)
2 if telescope see back.
 (size)
- (5) screen open
 (length) (depth to top)
 (size) (material)
- (6) pump 1 12
 (HP) (yield gpm)
Elec
 (type power)
- (7) electric log no
 (yes or no)
 (organization running log)
- (8) how well bottom plugged open

description of formations encountered

from

to

Clay + Dust	0	20
Sandy Sand	20	42
Grey Mud + Black	42	126
Dust slate		
mostly B.O.	126	143
Granite	143	146
Grey Chalk	146	150
Redr	150	151
Blue + Grey Chalk	151	200
Granite	200	205
Darker sand Chalk	205	231
Fine Sand	231	245
Coarse sand	245	335


CODED

DRILLERS REMARKS:

DEC 12 1973

If well telescopes please sketch and show depths.

GROUND LEVEL

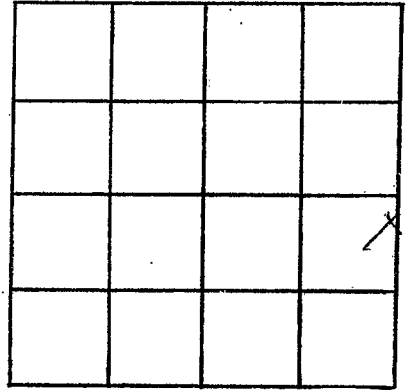

SECTION 30

Please indicate well location X.

ADDITIONAL INFORMATION

If more than one screen,
show locations of each on sketch.