

MONTGOMERY

B4

8-7-73

MISSISSIPPI
BOARD OF WATER COMMISSIONERS **CODED**
416 North State Street
Jackson, Mississippi 39201

WATER WELL DRILLERS LOG

8-7-73 Charles Loran Montgomery
(date well completed) firm name county well located

LANDOWNER: C.O. Hood
Duck Hill
Miss.
(mailing address)

description of formations encountered	from	to
Red Clay + little Sand	0	22
Blue Shale	22	66
Blue Sand	66	200
Blue Shale	200	220
White Sand	220	290
	290	330


WELL LOCATION:
sec. 21, T. 26 S R. 7 E
10 miles N.E. of Duck Hill
(distance) (direction) (nearest town)

WELL PURPOSE: Home
(home, irrigation, municipal, industrial)

- WELL COMPLETION DATA:
- diameter (inches) 4"
 - total depth (feet) 330'
 - static water level (feet) 26' below above top of ground.
 - casing plastic
(material) (depth)
(size) If telescope see back.
 - screen 140' 290'
(length) (depth to top)
2" plastic
(size) (material)
 - pump Electric 5
(HP) (yield gpm)
Electric
(type power)
 - electric log NO
(yes or no)
 - (organization running log)
 - how well bottom plugged Screened

CODED.

DRILLERS REMARKS:

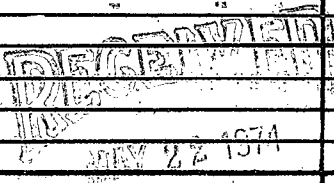

If well telescopes please sketch and show depths.

GROUND LEVEL

		X	

SECTION 21

Please indicate well location X.

ADDITIONAL INFORMATION

If more than one screen,
show locations of each on sketch.