

C1  
 MONTGOMERY CO  
 5-24-84

MISSISSIPPI  
 BOARD OF WATER COMMISSIONERS  
 416 North State Street  
 Jackson, Mississippi 39201

CODED

WATER WELL DRILLERS LOG

May 24 1984 Lipell Well Supply Montgomery  
 date well completed firm name county well located

LANDOWNER: <u>R Armstrong</u>	description of formations encountered	from	to
<u>85 Fifth St.</u>	<u>top soil &amp; clay</u>	<u>0</u>	<u>20</u>
<u>Gretnada Ms</u> (mailing address)	<u>clay</u>	<u>20</u>	<u>80</u>
WELL LOCATION: sec. <u>11</u> T <u>20</u> (N) S R <u>5</u> (E) W <u>1</u> miles <u>W</u> of <u>Dark Hill</u> (distance) (direction) (nearest town)	<u>SPAND</u>	<u>80</u>	<u>240</u>
WELL PURPOSE: <u>home</u> (home, irrigation, municipal, industrial)	<u>CLAY</u>	<u>240</u>	<u>280</u>
WELL COMPLETION DATA:			
(1) diameter (inches) <u>4"</u>			
(2) total depth (feet) <u>335</u>			
(3) static water level (feet) <u>65</u> <sup>(below)</sup> / <sub>(above)</sub> top of ground.			
(4) casing <u>Pvc</u> , <u>320</u> (material) (depth) <u>4</u> (size) if telescope see back.			
(5) screen <u>15</u> , <u>320</u> (length) (depth to top)			
(6) pump <u>4</u> , <u>PVC</u> (size) (material)			
(7) pump <u>1 1/2</u> , <u>20</u> (HP) (yield gpm) <u>elec</u> (type power)			
(7) electric log <u>NO</u> (yes or no)			
(organization running log)			
how well bottom plugged <u>PVC</u> <u>cap</u>			
DRILLERS REMARKS:			


DEPT. OF NATURAL RESOURCES  
 BUREAU OF LAND & WATER RESOURCES

MAY 29 1984

RECEIVED

If well telescopes please sketch and show depths.

GROUND LEVEL

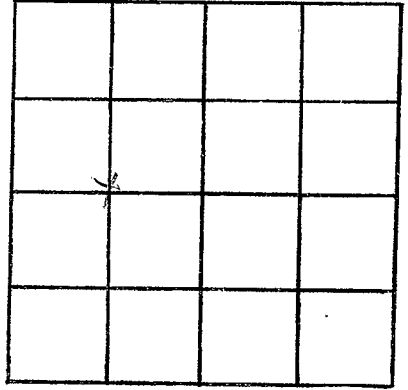

SECTION 11

Please indicate well location X.

ADDITIONAL INFORMATION

If more than one screen,  
show locations of each on sketch.