

C2
MONTGOMERY Co.
6-7-84

MISSISSIPPI
BOARD OF WATER COMMISSIONERS
416 North State Street
Jackson, Mississippi 39201

CODED

WATER WELL DRILLERS LOG

Site No. 7 1984 Lipe Wells & Supply Montgomery
date well completed firm name county well located

LANDOWNER: <u>R. Armstrong</u>	description of formations encountered	from	to
<u>85 First St.</u>			
<u>Brenada Ms.</u> (mailing address)	top soil + clay	0	20
WELL LOCATION: sec. <u>11 T 20 N</u> R. <u>5 E</u>	clay	20	80
<u>1</u> miles <u>West</u> of <u>Duckhill</u> (distance) (direction) (nearest town)	SAND	80	240
WELL PURPOSE: <u>home</u> (home, irrigation, municipal, industrial)	clay	240	290
WELL COMPLETION DATA:	clay	290	300
(1) diameter (inches) <u>4 1/2</u>	SAND	300	340
(2) total depth (feet) <u>587</u>	SAND + clay	340	390
(3) static water level (feet) <u>75</u> (below above top of ground)	SAND	390	440
(4) casing <u>PVC</u> (material) (depth)	Rock	440	475
(size) if telescope see back.	SAND	475	490
(5) screen <u>10</u> <u>548</u> (length) (depth to top)	clay	490	510
<u>1 1/2</u> <u>Superior Steel</u> (size) (material)	SAND	510	530
(6) pump <u>1 1/2</u> <u>20</u> (HP) (yield gpm)	clay	530	550
<u>elec</u> (type power)	SAND	550	570
(7) electric log <u>N</u> (yes or no)	clay	570	587
(organization running log)			
(8) how well bottom plugged <u>steel cap</u>			
DRIILLERS REMARKS:			

DEPT. OF NATURAL RESOURCES
BUREAU OF LAND & WATER RESOURCES

JUN 11 1984
RECEIVED

If well telescopes please sketch and show depths.

GROUND LEVEL

335

4" PVC

548


2 5/8" steel

558

10' SS screen

567

2 2/8" steel

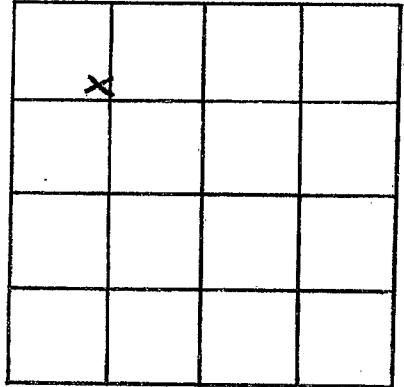

SECTION 11

Please indicate well location X.

ADDITIONAL INFORMATION

If more than one screen, show locations of each on sketch.