

Montgomery
D6
8-30-68

MISSISSIPPI
BOARD OF WATER COMMISSIONERS
416 North State Street
Jackson, Mississippi 39201

CODED

WATER WELL DRILLERS LOG

THOMAS WELL DRILLING CO.

Montgomery

8-30
date well completed

1968

RT. 4, BOX 444, Barlow, Phone 289-3691
KOSCIUSKO, MISSISSIPPI

county well located

LANDOWNER: Curtis Sikes

description of formations encountered

from to

Dockhill, Miss.
(mailing address)

Red Clay	0	15
SAND	15	45
CHALKY SAND	45	61
HIT CAVE	61	
COULDN'T GET ANY RETURNS FROM HERE ON DOWN. DRILLED LIKE GOOD SAND HIT HARD DIRT AT 84 FT.		

WELL LOCATION:
sec. 13 T 20 N R 6 E
S W
5 miles S.E. of Dockhill
(distance) (direction) (nearest town)

WELL PURPOSE:
(Home, Irrigation, municipal, industrial)

WELL COMPLETION DATA:


- (1) diameter (inches) 2
- (2) total depth (feet) 84
- (3) static water level (feet) 55 (below) above top of ground.
- (4) casing Galv. 78, (material) (depth)
2" (size) if telescope see back.
- (5) screen 6, 78 (length) (depth to top)
8 slot 1 1/4" stainless steel (size) (material)
- (6) pump 1, 5 (HP) (yield gpm)
Elec (type power)
- (7) electric log NO (yes or no)

(organization running log)

(8) how well bottom plugged


DRILLERS REMARKS:

CODED

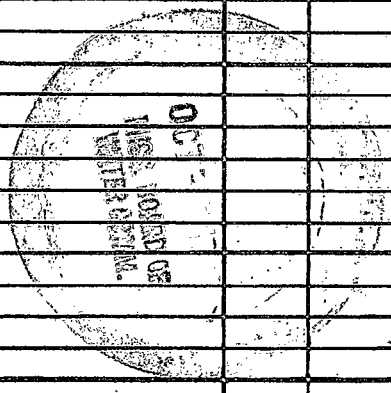

If well telescopes please sketch and show depths.

GROUND LEVEL

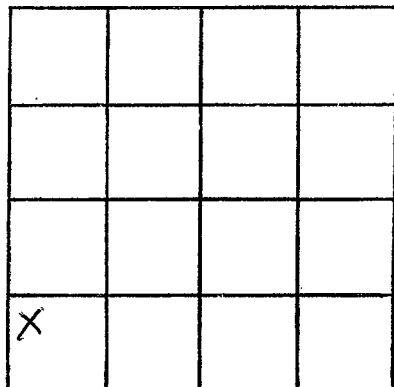

SECTION B

Please indicate well location X.

ADDITIONAL INFORMATION

If more than one screen, show locations of each on sketch.