

6W-01298

coded.

D2 was a test hole.  
This well is D9.

Montgomery

D9

12-66

Elec. Log

MISSISSIPPI  
BOARD OF WATER COMMISSIONERS  
416 North State Street  
Jackson, Mississippi 39201

CWW  
9/19/05

CODED

WATER WELL DRILLERS LOG

12-22-66 19  
date well completed

Robert E. Rathiff Co.  
firm name

Montgomery  
county well located

LANDOWNER: Eskridge

Rose Hill water basin

Duck Hill miss.  
(mailing address)

description of formations  
encountered

from to

Duckshot Sand	0	24
Sand, Shale	24	46
Sand, shale streaks	46	69
Sand	69	92
Sand	92	100
Shale	100	114
Sand, shale streaks	114	137
Sand	137	171
Shale	171	183
Shale rocks	183	205
Sandy Shale	205	227
Sand	227	249
Sandy Shale	249	415
Shale	415	467
Sandy Shale	467	489
Sand	489	535

WELL LOCATION:

SE NE 18 20 N  
sec. T. R. 6 E  
1 1/2 miles S of Duck Hill  
(distance) (direction) (nearest town)


WELL PURPOSE: municipal  
(home, irrigation, municipal, industrial)

WELL COMPLETION DATA:

- (1) diameter (inches) 8 x 4
- (2) total depth (feet) 535
- (3) static water level (feet) 41 below top of ground.
- (4) casing Bl. Steel 490 (material) (depth)
- (5) screen 40 490 (length) (depth to top)  
4" 5.S. (size) (material)
- (6) pump 10 105 (HP) (yield gpm)
- (7) electric log M.S.D. (yes or no) (USGS #21) test hole D2
- (8) how well bottom plugged L.P.V.


CODED

CODED

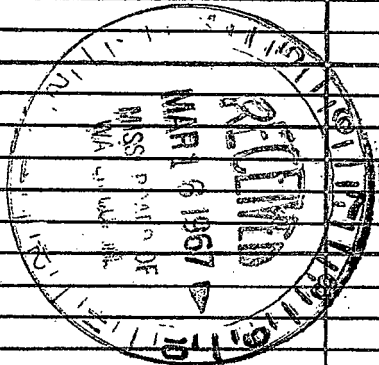

DRILLERS REMARKS:

If well telescopes please sketch and show depths.

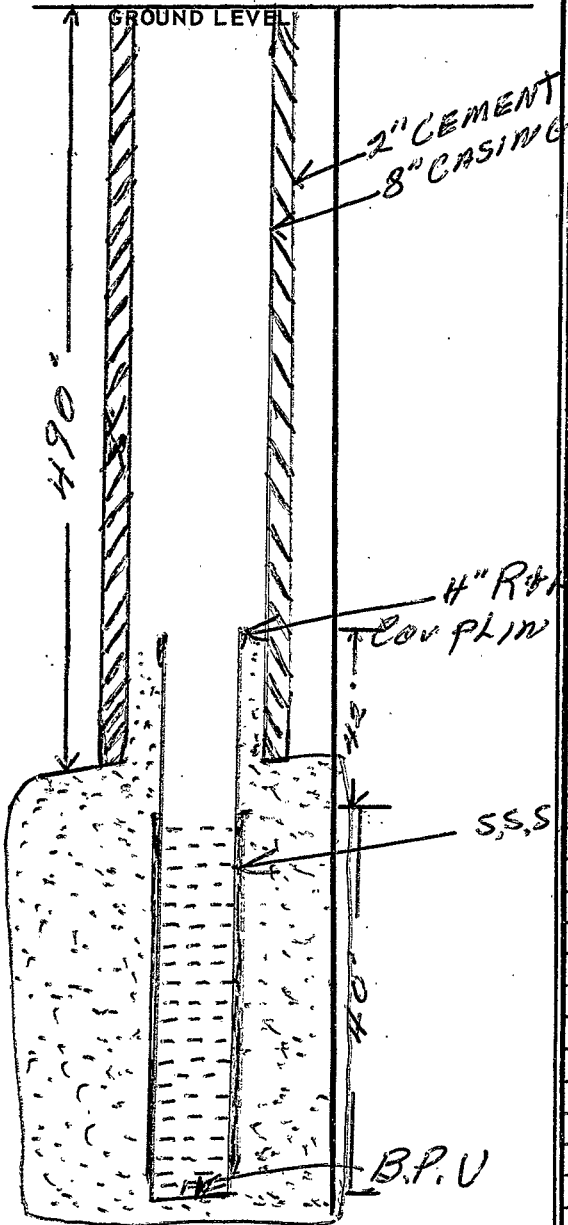

			X

SECTION 18

Please indicate well location X.

ADDITIONAL INFORMATION

If more than one screen, show locations of each on sketch.