

**MONTGOMERY**  
**D 10**  
**12-12-72**

MISSISSIPPI  
 BOARD OF WATER COMMISSIONERS  
 416 North State Street  
 Jackson, Mississippi 39201

WATER WELL DRILLERS LOG

**CODED**

12-12-72 date well completed 1972 Thomas & Son firm name Montgomery county well located


| LANDOWNER: Roy Hathcock                               | description of formations encountered | from | to  |
|---|---------------------------------------|------|-----|
| Rt-1  | Red Clay                              | 0    | 3   |
| Duck Hill, Miss                                       | Coarse Sand                           | 3    | 7   |
| (mailing address)                                     | White Chalk                           | 7    | 11  |
| WELL LOCATION:  | Red Sand Rock & Sand                  | 11   | 20  |
| sec 33 T 20 N R 6 E                                   | Black Dirt                            | 20   | 37  |
| 6 miles SE of Duck Hill                               | 5 1/2 ft's Hard Black Dirt            | 37   | 105 |
| (distance) (direction) (nearest town)                 | & Fine Sand                           |      |     |
| WELL PURPOSE:   | White Sand                            | 105  | 231 |
| (Home, Irrigation, municipal, industrial)             |                                       |      |     |
| WELL COMPLETION DATA:                                 |                                       |      |     |
| (1) diameter (inches) 2 1/2                           |                                       |      |     |
| (2) total depth (feet) 231                            |                                       |      |     |
| (3) static water level (feet) 70 below top of ground. |                                       |      |     |
| (4) casing PVC, 221 (material) (depth)                |                                       |      |     |
| 2 (size) if telescope see back.                       |                                       |      |     |
| (5) screen 10, 221 (length) (depth to top)            |                                       |      |     |
| 2" 8.5/64 PVC (size) (material)                       |                                       |      |     |
| (6) pump 1 (HP) 6 (yield gpm)                         |                                       |      |     |
| Elec (type power)                                     |                                       |      |     |
| (7) electric log no (yes or no)                       |                                       |      |     |
| (organization running log)                            |                                       |      |     |
| (8) how well bottom plugged Point                     |                                       |      |     |
| DRILLERS REMARKS:                                     |                                       |      |     |

**CODED**

JAN 3 1972

If well telescopes please sketch and show depths.

GROUND LEVEL

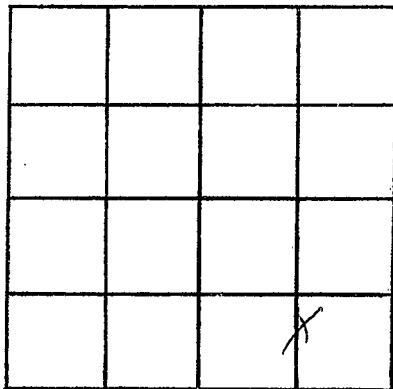

SECTION 33

Please indicate well location X.

ADDITIONAL INFORMATION

If more than one screen,  
show locations of each on sketch.