

Montgomery Co  
 D 26  
 10-69

MISSISSIPPI  
 BOARD OF WATER COMMISSIONERS  
 416 North State Street  
 Jackson, Mississippi 39201

WATER WELL DRILLERS LOG

10-15 1969  
 date well completed

Herndon-Homan Well & Supply, Inc. *Montgomery*  
 P. O. Box 42  
 SHANNON, MISSISSIPPI 38868  
 county well located

LANDOWNER: *Laura J Duck*  
*Hill,*  
*Duck Hill, Miss*  
 (mailing address)

WELL LOCATION:  
 sec. *6* T. *26N* R. *6E*  
 (distance) miles (direction) of (nearest town)

WELL PURPOSE: *Municipal*  
 (home, irrigation, municipal, industrial)

WELL COMPLETION DATA:  
 (1) diameter (inches) *8"*  
 (2) total depth (feet) *656*  
 (3) static water level (feet) *28* below top of ground.  
 (4) casing *Steel*, *395'*  
 (material) (depth)  
*8"* If telescope see back.  
 (size)  
 (5) screen *60'*, *395'*  
 (length) (depth to top)  
*4" x 3"*, *304 Stainless*  
 (size) (material)  
 (6) pump *20* *150*  
 (HP) (yield gpm)  
*Electric*  
 (type power)  
 (7) electric log *yes*  
 (yes or no) (USGS # 30)  
*W&H S*  
 (organization running log)  
 (8) how well bottom plugged  
*Backwash*

description of formations encountered	from	to
<i>Red Clay</i>	<i>0</i>	<i>10</i>
<i>White Chalk</i>	<i>10</i>	<i>38</i>
<i>Coarse white sand</i>	<i>38</i>	<i>125</i>
<i>Lime Rock</i>	<i>125</i>	<i>210</i>
<i>Sand</i>	<i>210</i>	<i>220</i>
<i>Lime Rock</i>	<i>220</i>	<i>300</i>
<i>Sand</i>	<i>300</i>	<i>310</i>
<i>Lime Rock</i>	<i>310</i>	<i>372</i>
<i>Rock</i>	<i>372</i>	<i>375</i>
<i>Lime Rock</i>	<i>375</i>	<i>395</i>
<i>Sand - Good</i>	<i>395</i>	<i>425</i>
<i>Gummy Blue Clay</i>	<i>425</i>	<i>430</i>
<i>Sand</i>	<i>430</i>	<i>437</i>
<i>Gummy Blue Clay</i>	<i>437</i>	<i>448</i>
<i>Sand</i>	<i>448</i>	<i>455</i>
<i>Gummy Blue Clay</i>	<i>455</i>	<i>493</i>
<i>Rock</i>	<i>493</i>	<i>495</i>
<i>Gummy Blue Clay</i>	<i>495</i>	<i>550</i>
<i>Sand</i>	<i>550</i>	<i>565</i>
<i>Gummy Blue Clay</i>	<i>565</i>	<i>620</i>
<i>Sand</i>	<i>620</i>	<i>656</i>

DRILLERS REMARKS:

8

If well telescopes please sketch and show depths.

GROUND LEVEL


SECTION 6

Please indicate well location X.

ADDITIONAL INFORMATION

395' of  
8" casing

20' screen

20' screen

20' screen

GRAVEL  
PACK

Total Depth  
656'

If more than one screen,  
show locations of each on sketch.

**MISSISSIPPI DEPARTMENT OF ENVIRONMENTAL QUALITY**  
**Office of Land and Water Resources**  
 P. O. Box 2309  
 Jackson, MS 39225  
**Water Well Plugging/Decommissioning Form**  
 OLWR-DF-1 (04/08)  
 (601)961-5555 (601)961-5228 (fax)

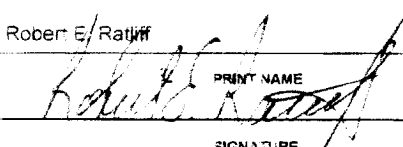
490002-01

COUNTY WELL LOCATED: MONTGOMERY	WELL NUMBER: ONE-D0026
PERMIT NUMBER: MS-GW-00311	DATE WELL PLUGGED: Nov. 2017
NAME OF FIRM PLUGGING WELL: RATLIFF WATER WELL SERVICE	TELEPHONE NUMBER: 6624581083
NAME AND ADDRESS OF CURRENT LANDOWNER: TOWN OF DUCK HILL, MISSISSIPPI P.O. BOX 368, DUCK HILL, MS. 38925	
WELL LOCATION: DUCK HILL SECTION: 6 TOWNSHIP: T20N RANGE: R6E	
WELL LOCATION: LATITUDE: 33.630 LONGITUDE: 89.7115 METHOD (Check ONE): <input type="checkbox"/> USGS QUAD <input type="checkbox"/> CONVENTIONAL SURVEY <input checked="" type="checkbox"/> GPS - HAND HELD OR SURVEY GRADE	
DISTANCE: 600' DIRECTION: SOUTH NEAREST TOWN: HWY 51 OTHER LANDMARK:	
WELL PURPOSE (HOME, IRRIGATION, MUNICIPAL, ETC.): MUNICIPAL	
NAME OF WELL CONTRACTOR WHO DRILLED THE WELL: HERNDON WELL	
NAME OF LANDOWNER WHEN WELL WAS DRILLED: TOWN OF DUCK HILL, MS.	

WELL DATA		
WELL DEPTH: 656	HOLE DEPTH: 656	
CASING DIAMETER (IN.): 3"	CASING LENGTH (FT.): 356'	TYPE OF CASING: Steel
DEPTH TO STATIC WATER LEVEL: 73'	DATE WELL COMPLETED: 10-15-69	
WHY IS THE WELL BEING ABANDONED? Pumping Sand		

DESCRIBE HOW THE WELL OR HOLE WAS PLUGGED (AMOUNT OF CASING AND/OR SCREEN THAT WAS REMOVED OR LEFT IN HOLE, MATERIAL AND AMOUNT USED IN PLUGGING, METHOD OF PLACING MATERIAL, ETC.)  Halliburton Method, 4.5 yds. neat cement, tremie pipe. No Material Removed

RECEIVED  
 SEP 07 2018  
 BY OLWR

I CERTIFY THAT THE WELL WAS PLUGGED OR ABANDONED IN ACCORDANCE WITH THE STATE OF MISSISSIPPI REGULATIONS.	
Robert E. Ratliff	9-002
	MS LICENSE NUMBER
PRINT NAME	Nov. 2017
SIGNATURE	DATE