

MONTGOMERY

D27

~~1-70~~

MISSISSIPPI
 BOARD OF WATER COMMISSIONERS
 416 North State Street
 Jackson, Mississippi 39201

CODED

WATER WELL DRILLERS LOG

JAN

19

70 Thomas & Son

Montgomery

date well completed

firm name

county well located

LANDOWNER: M. EARL BAILEY

description of formations encountered

from

to

Rt-2

Red CLAY

0

15

DOCK HILL, MISS.

SAND

15

31

(mailing address)

Black Dirt

31

42

5 1/2 Black Dirt + Sand

42

88

WELL LOCATION:

Real Course SAND

88

97

sec. 22 T 20 N R 6 E
 S W
4 miles SE of DOCK HILL
 (distance) (direction) (nearest town)

WELL PURPOSE:

(home, irrigation, municipal, industrial)

WELL COMPLETION DATA:

- (1) diameter (inches) 2
- (2) total depth (feet) 97
- (3) static water level (feet) 50 ^{below} _{above} top of ground.
- (4) casing PVC 92
 (material) (depth)
2 if telescope see back.
 (size)
- (5) screen 5 92
 (length) (depth to top)
1 1/4 5-5
 (size) (material)
- (6) pump 3/4 6
 (HP) (yield gpm)
Motor
 (type power)
- (7) electric log NZ
 (yes or no)

(organization running log)

(8) how well bottom plugged


DRILLERS REMARKS:

FFR 6-19/00

MISS. BD. OF WATER COMMISSIONERS

If well telescopes please sketch and show depths.

GROUND LEVEL

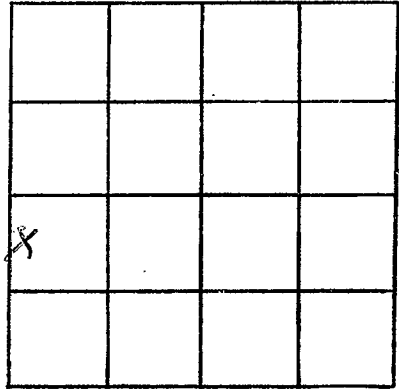

SECTION 22

Please indicate well location X.

ADDITIONAL INFORMATION

If more than one screen,
show locations of each on sketch.