

MONTGOMERY  
D 28  
1- 70

MISSISSIPPI  
BOARD OF WATER COMMISSIONERS  
416 North State Street  
Jackson, Mississippi 39201

CODED

WATER WELL DRILLERS LOG

JAN 1970 Thomas Saw Montgomery  
date well completed firm name county well located

LANDOWNER: <u>Mr. Russell Ponce</u>	description of formations encountered	from	to
<u>Rt 2</u>			
<u>Duck Hill Miss.</u> (mailing address)	<u>Dirt</u>	<u>0</u>	<u>21</u>
	<u>CHALK &amp; SAND</u>	<u>21</u>	<u>30</u>
	<u>CHALK</u>	<u>30</u>	<u>42</u>
	<u>Course SAND</u>	<u>42</u>	<u>68</u>

WELL LOCATION:  
sec. 28 T 20 N R. 6 E  
S W  
4 miles SE of Duck Hill  
(distance) (direction) (nearest town)

WELL PURPOSE:  
(Home, Irrigation, municipal, industrial)

- WELL COMPLETION DATA:
- (1) diameter (inches) 2
  - (2) total depth (feet) 68
  - (3) static water level (feet) 30 below top of ground above
  - (4) casing PVC, 63,  
(material) (depth)  
2 if telescope see back.  
(size)
  - (5) screen 5, 63  
(length) (depth to top)  
1/4, S.S.  
(size) (material)
  - (6) pump 3/4, 6  
(HP) (yield gpm)  
Electric  
(type power)
  - (7) electric log no  
(yes or no)
  - (8) how well bottom plugged \_\_\_\_\_  
(organization running log)


DRILLERS REMARKS:

FEB 6 - 1970

MISS. DEPT. OF  
WATER RESOURCES

If well telescopes please sketch and show depths.

GROUND LEVEL

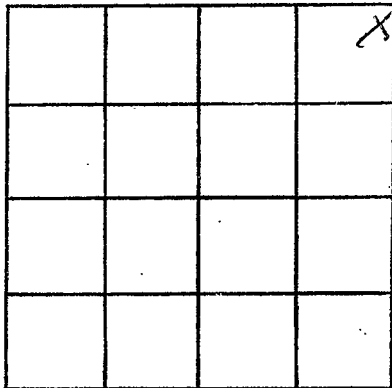

SECTION 28

Please indicate well location X.

ADDITIONAL INFORMATION

If more than one screen, show locations of each on sketch.